

## NOBLESVILLE SCHOOLS

ENGAGE | INSPIRE | EMPOWER

# NOBLESVILLE HIGH SCHOOL SOFTBALL LOCKER ROOM BUILDING

### 100% CONSTRUCTION DOCUMENTS

18111 Cumberland Rd, Noblesville, IN 46060

JANUARY 10, 2025

#### SHEET INDEX

#### <u>CIVIL</u>

C010	TITLE SHEET
C001	TOPO PLAN
C110	DEMO PLAN
C111	DEMO PLAN
C112	ALTERNATE #1 DEMO PLAN
C113	ALTERNATE #2 DEMO PLAN
C114	ALTERNATE #3 DEMO PLAN
C310	GRADING PLAN
C311	ALTERNATE #1 GRADING PLAN
C312	ALTERNATE #2 GRADING PLAN
C313	ALTERNATE #3 GRADING PLAN
C410	DRAINAGE PLAN
C510	UTILITY PLAN
C511	OVERALL UTILITY PLAN
C910	STORMWATER POLLUTION PREVENTION PLAN
C911	STORMWATER POLLUTION PREVENTION PLAN
C912	ALTERNATE #1 STORMWATER POLLUTION PREVENTION PLAN
C913	ALTERNATE #2 STORMWATER POLLUTION PREVENTION PLAN
C914	ALTERNATE #3 STORMWATER POLLUTION PREVENTION PLAN

STORMWATER POLUTION PREVENTION NOTES

C916 STORMWATER POLLUTION PREVENTION DETAILS

#### <u>LANDSCAPE</u>

~	₾#0%~~	MATERIALS AND NOTES PEAN
٤,	L102A	SITE ALTERNATE DIAGRAMING
<u> </u>	1202	CAYOUT PLAN
	L600	SITE DETAILS
	L602	SITE DETAILS

#### **STRUCTURAL**

S001	GENERAL STRUCTURAL NOTES
S201	FOUNDATION & ROOF FRAMING PLANS
S401	TYPICAL DETAILS
S402	TYPICAL DETAILS
S701	SECTIONS AND DETAIL

#### ARCHITECTURAL

/11101	HTEGICIA/AE
~~~~	
^{ AD201	DEMO FLOOR PLAN AND SECTIONS
11/4201~	FLOORPHANAMOROOFPHAN
A202	REFLECTED CEILING PLANS
A301	BUILDING ELEVATIONS
A302	BUILDING SECTIONS
A501	SCHEDULES, ENLARGED PLAN AND INTERIOR ELEVATIONS
A 0.04	CINICLI DI ANI

#### <u>PLUMBING</u>

PM001	SYMBOLS, ABBREVIATIONS, GENERAL NOTES - MECHANICAL
P201	SOFTBALL LOCKER ROOM - PLUMBING
P401	SCHEDULES AND DETAILS - PLUMBING

#### **MECHANICAL**

M201	SOFTBALL LOCKER ROOM - MECHANICAL
M220	ROOF PLAN - MECHANICAL
M401	DETAILS - MECHANICAL
M601	SCHEDULES - MECHANICAL

### **ELECTRICAL**

E001	SYMBOLS, ABBREVIATIONS, & GENERAL NOTES - ELECTRICAL
E100	SITE PLAN - ELECTRICAL
E101	SITE PLAN - PHOTOMETRICS
E201	SOFTBALL LOCKER ROOM - ELECTRICAL
E401	DETAILS - ELECTRICAL
E501	RISER DIAGRAM - ELECTRICAL
E601	SCHEDULES - ELECTRICAL

#### <u>TELECOM</u>

T001	SYMBOLS, ABBREVIATIONS, & GENERAL NOTES - TELECOM.
T100	SITE PLAN - TELECOM.
T201	SOFTBALL LOCKER ROOM - TELECOM.
T401	DETAILS - TELECOM. BONDING AND GROUNDING
T402	DETAILS - TELECOM. PHYSICAL SECURITY
T403	DETAILS - TELECOM. BACKBONE AND ROUGH-INS
T404	OSP DETAILS - TELECOM

#### ARCHITECT MECHANICAL/ELECTRI



8831 Keystone Crossing, Indianapolis, IN 46240 317.848.7800 | csoinc.net

#### MECHANICAL/ELECTRICAL/PLUMBING ENGINEER



732 N Capitol Avenue, Indianapolis, IN 46204 317.634.4672 | redimond.com

#### STRUCTURAL ENGINEER



550 Virginia Avenue, Indianapolis, IN 46203 317.423.1550 | Ihb-eng.com

### **CIVIL ENGINEER**



530 E. Ohio Street, Suite G, Indianapolis, IN 46204 317.655.7777 | cecinc.com

#### LANDSCAPE ARCHITECT



5825 Lawton Loop E Drive, Indianapolis, IN 46216 317.485.6900 | context-design.com NOBLESVILLE SCHOOL

SRCHITECTURE · INTERIOR DESIGN

ARCHITECTURE · INTERIOR DESIGN

317.848.7800 | csoinc.net

SOFTBALL LOCKER ROOM BUILDING

SVILLE HIGH SCHOOL

SCOPE DRAWINGS:

These drawings indicate the general scope of the project in terms of architectural design concept, the dimensions of the building, the major architectural elements and the type of structural, mechanical and electrical systems.


The drawings do not necessarily indicate or describe all work required for full performance and completion of the requirements of the Contract.

On the basis of the general scope indicated or described, the trade contractors shall furnish all items required for the proper execution and completion of the work.

OOL
ROOM BUILDING
CUMENTS

NOBLESVILLE HIGH SCHOOL
SOFTBALL LOCKER ROC
100% CONSTRUCTION DOCUM
JANUARY 10, 2025

2024079

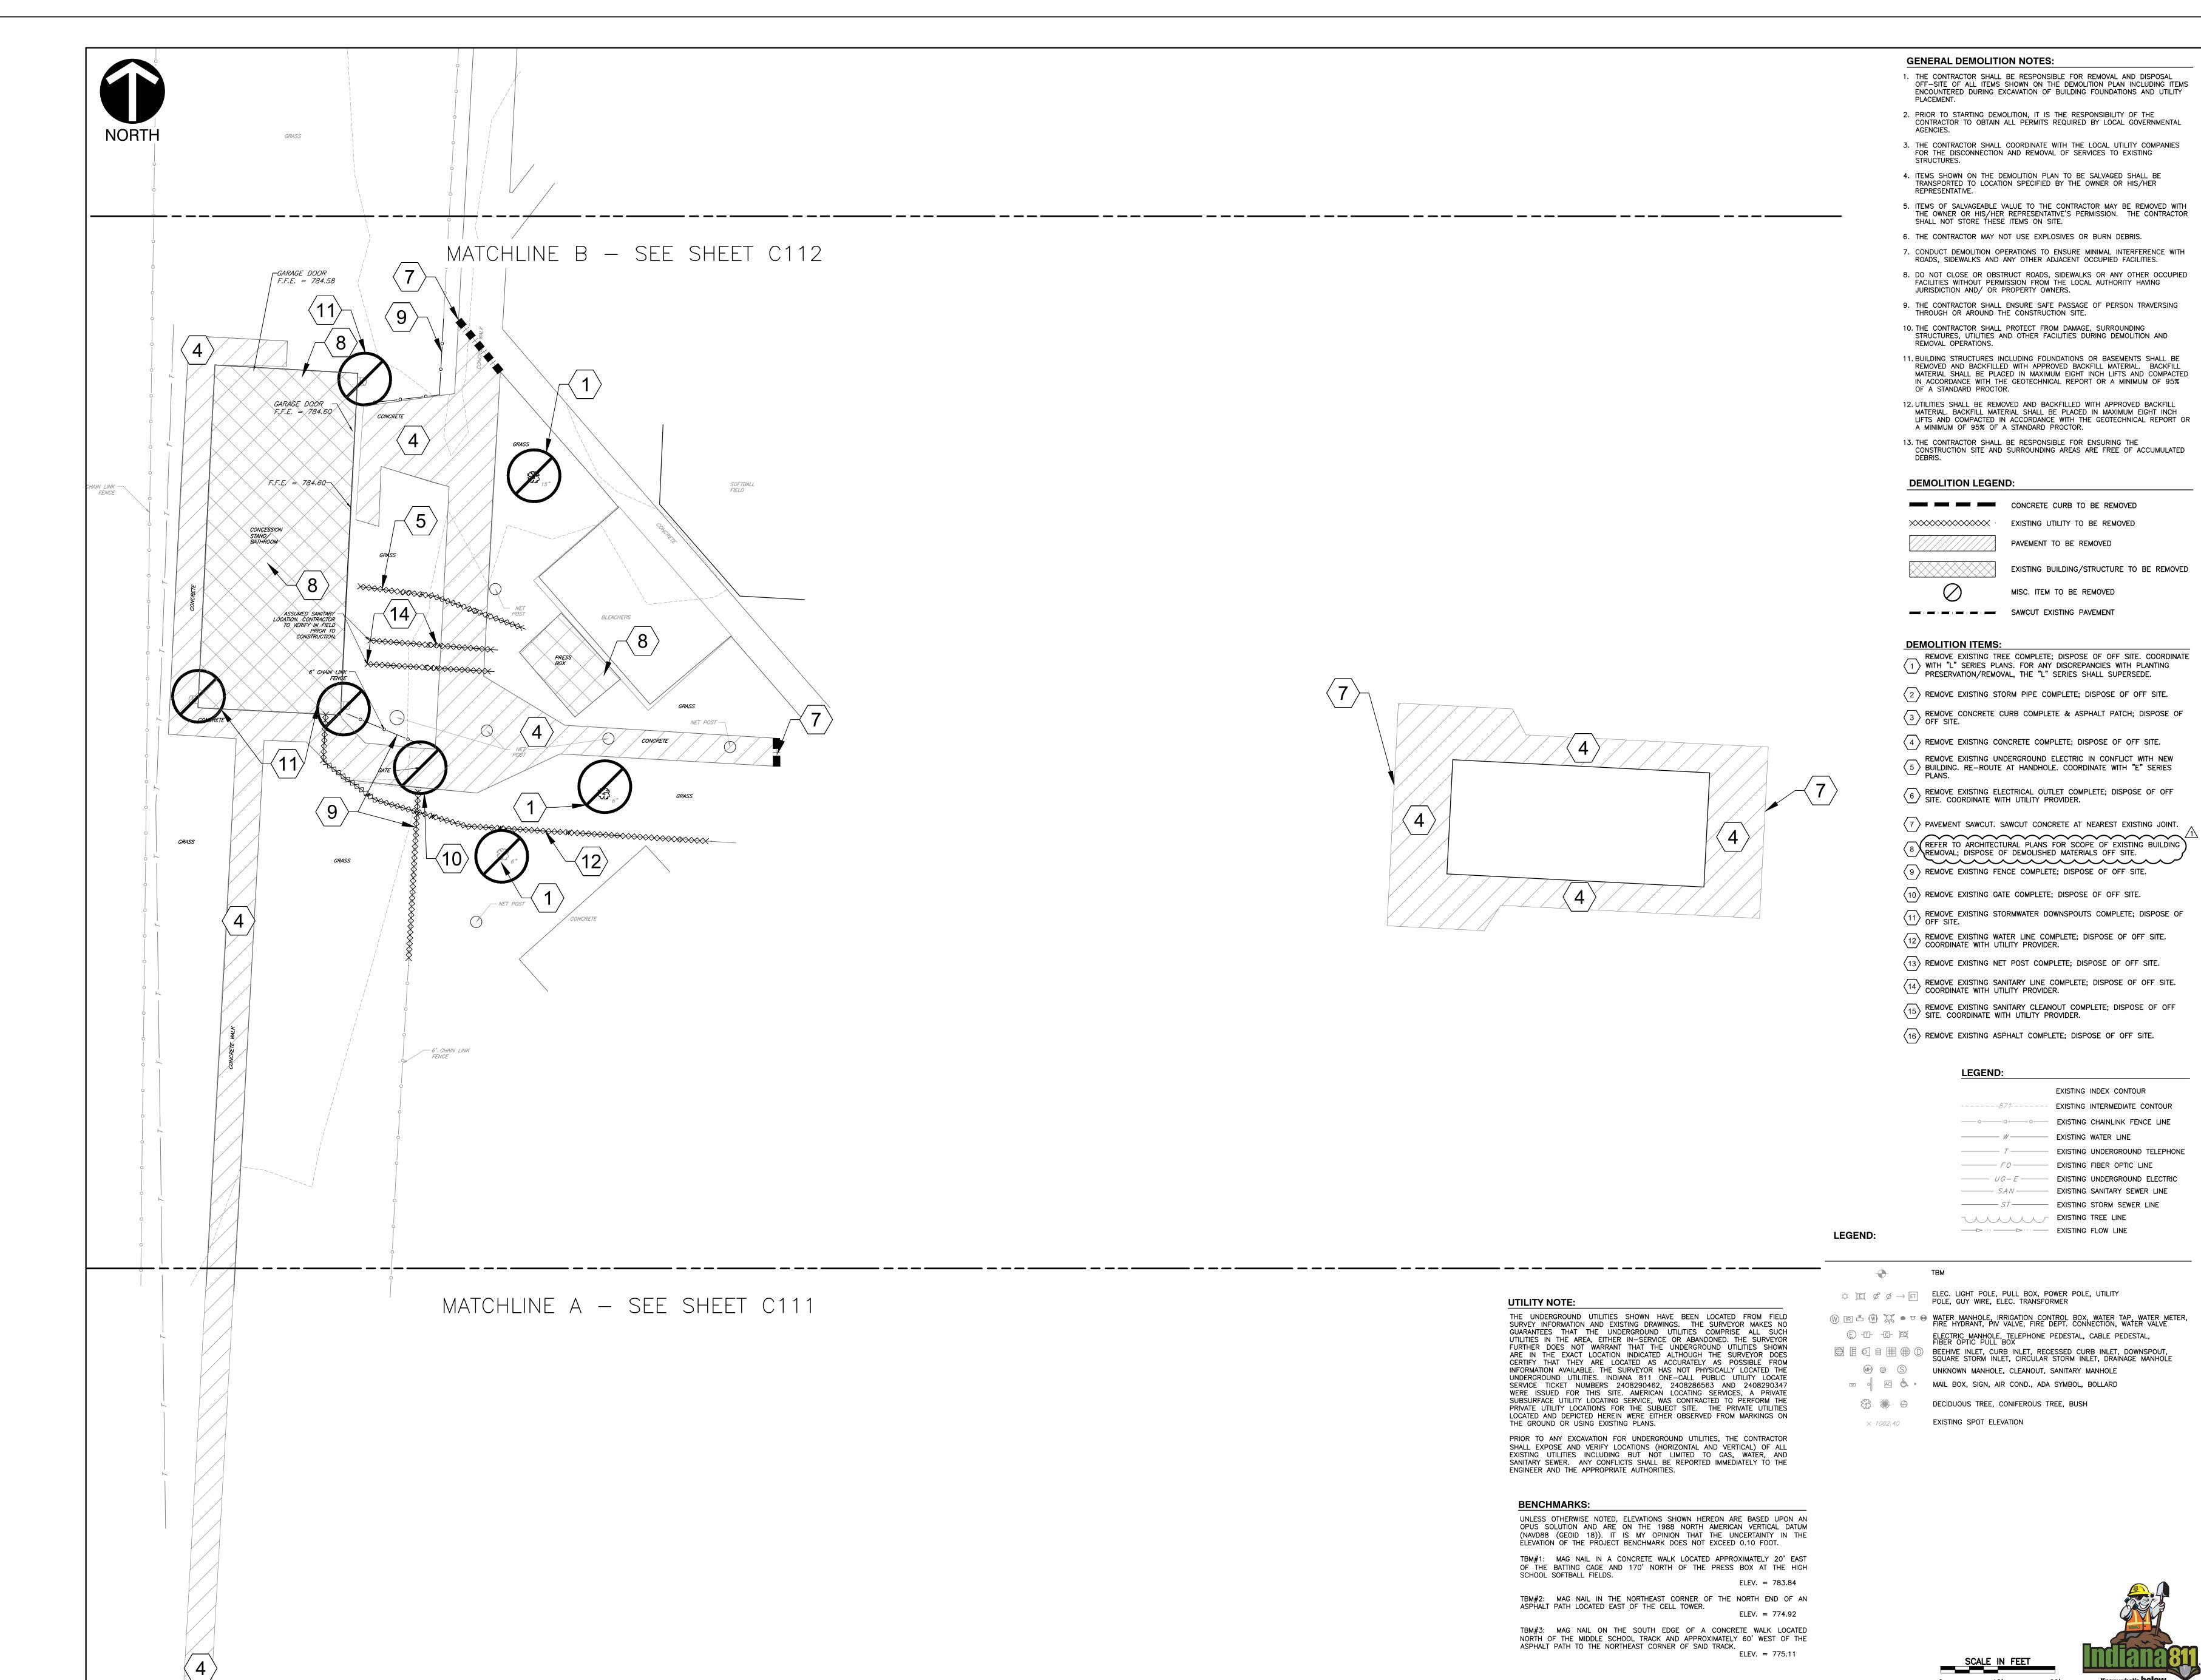

NOBLESVILLE SCHOOLS ENGAGE | INSPIRE | EMPOWER

Ssing, Indianapolis, IN 46240
7800 | csoinc.net

8831 Keystone Crossing, Indianapolis, 317.848.7800 | csoinc.net

nvironmental Consultants, io Street · Suite G - Indianapolis, IN 4620, 317-655-7777 · 877-746-0749

LESVILLE SCHOOLS
SVILLE HIGH SCHOOL
CESSION BUILDINGS
D DR, NOBLESVILLE, IN 46060

SCOPE DRAWINGS:

These drawings indicate the general scope of the project terms of architectural design concept, the dimensions of he building, the major architectural elements and the type if structural, mechanical and electrical systems.

The drawings do not necessarily indicate or describe all rork required for full performance and completion of the equirements of the Contract.

On the basis of the general scope indicated or described he trade contractors shall furnish all items required for the roper execution and completion of the work.

REVISIONS:

101/17/2025 - ADDENDUM #01

ISSUE DATE DRAWN BY CHECKED BY
01/09/25 SRD JMP

DRAWING TITLE:

DEMO PLAN

CERTIFIED BY:

No. PE12100829

STATE OF

WDIANA


STONAL ENGLISH

O1/09/2025

DRAWING NUMBER

PROJECT NUMBER

DRAFT

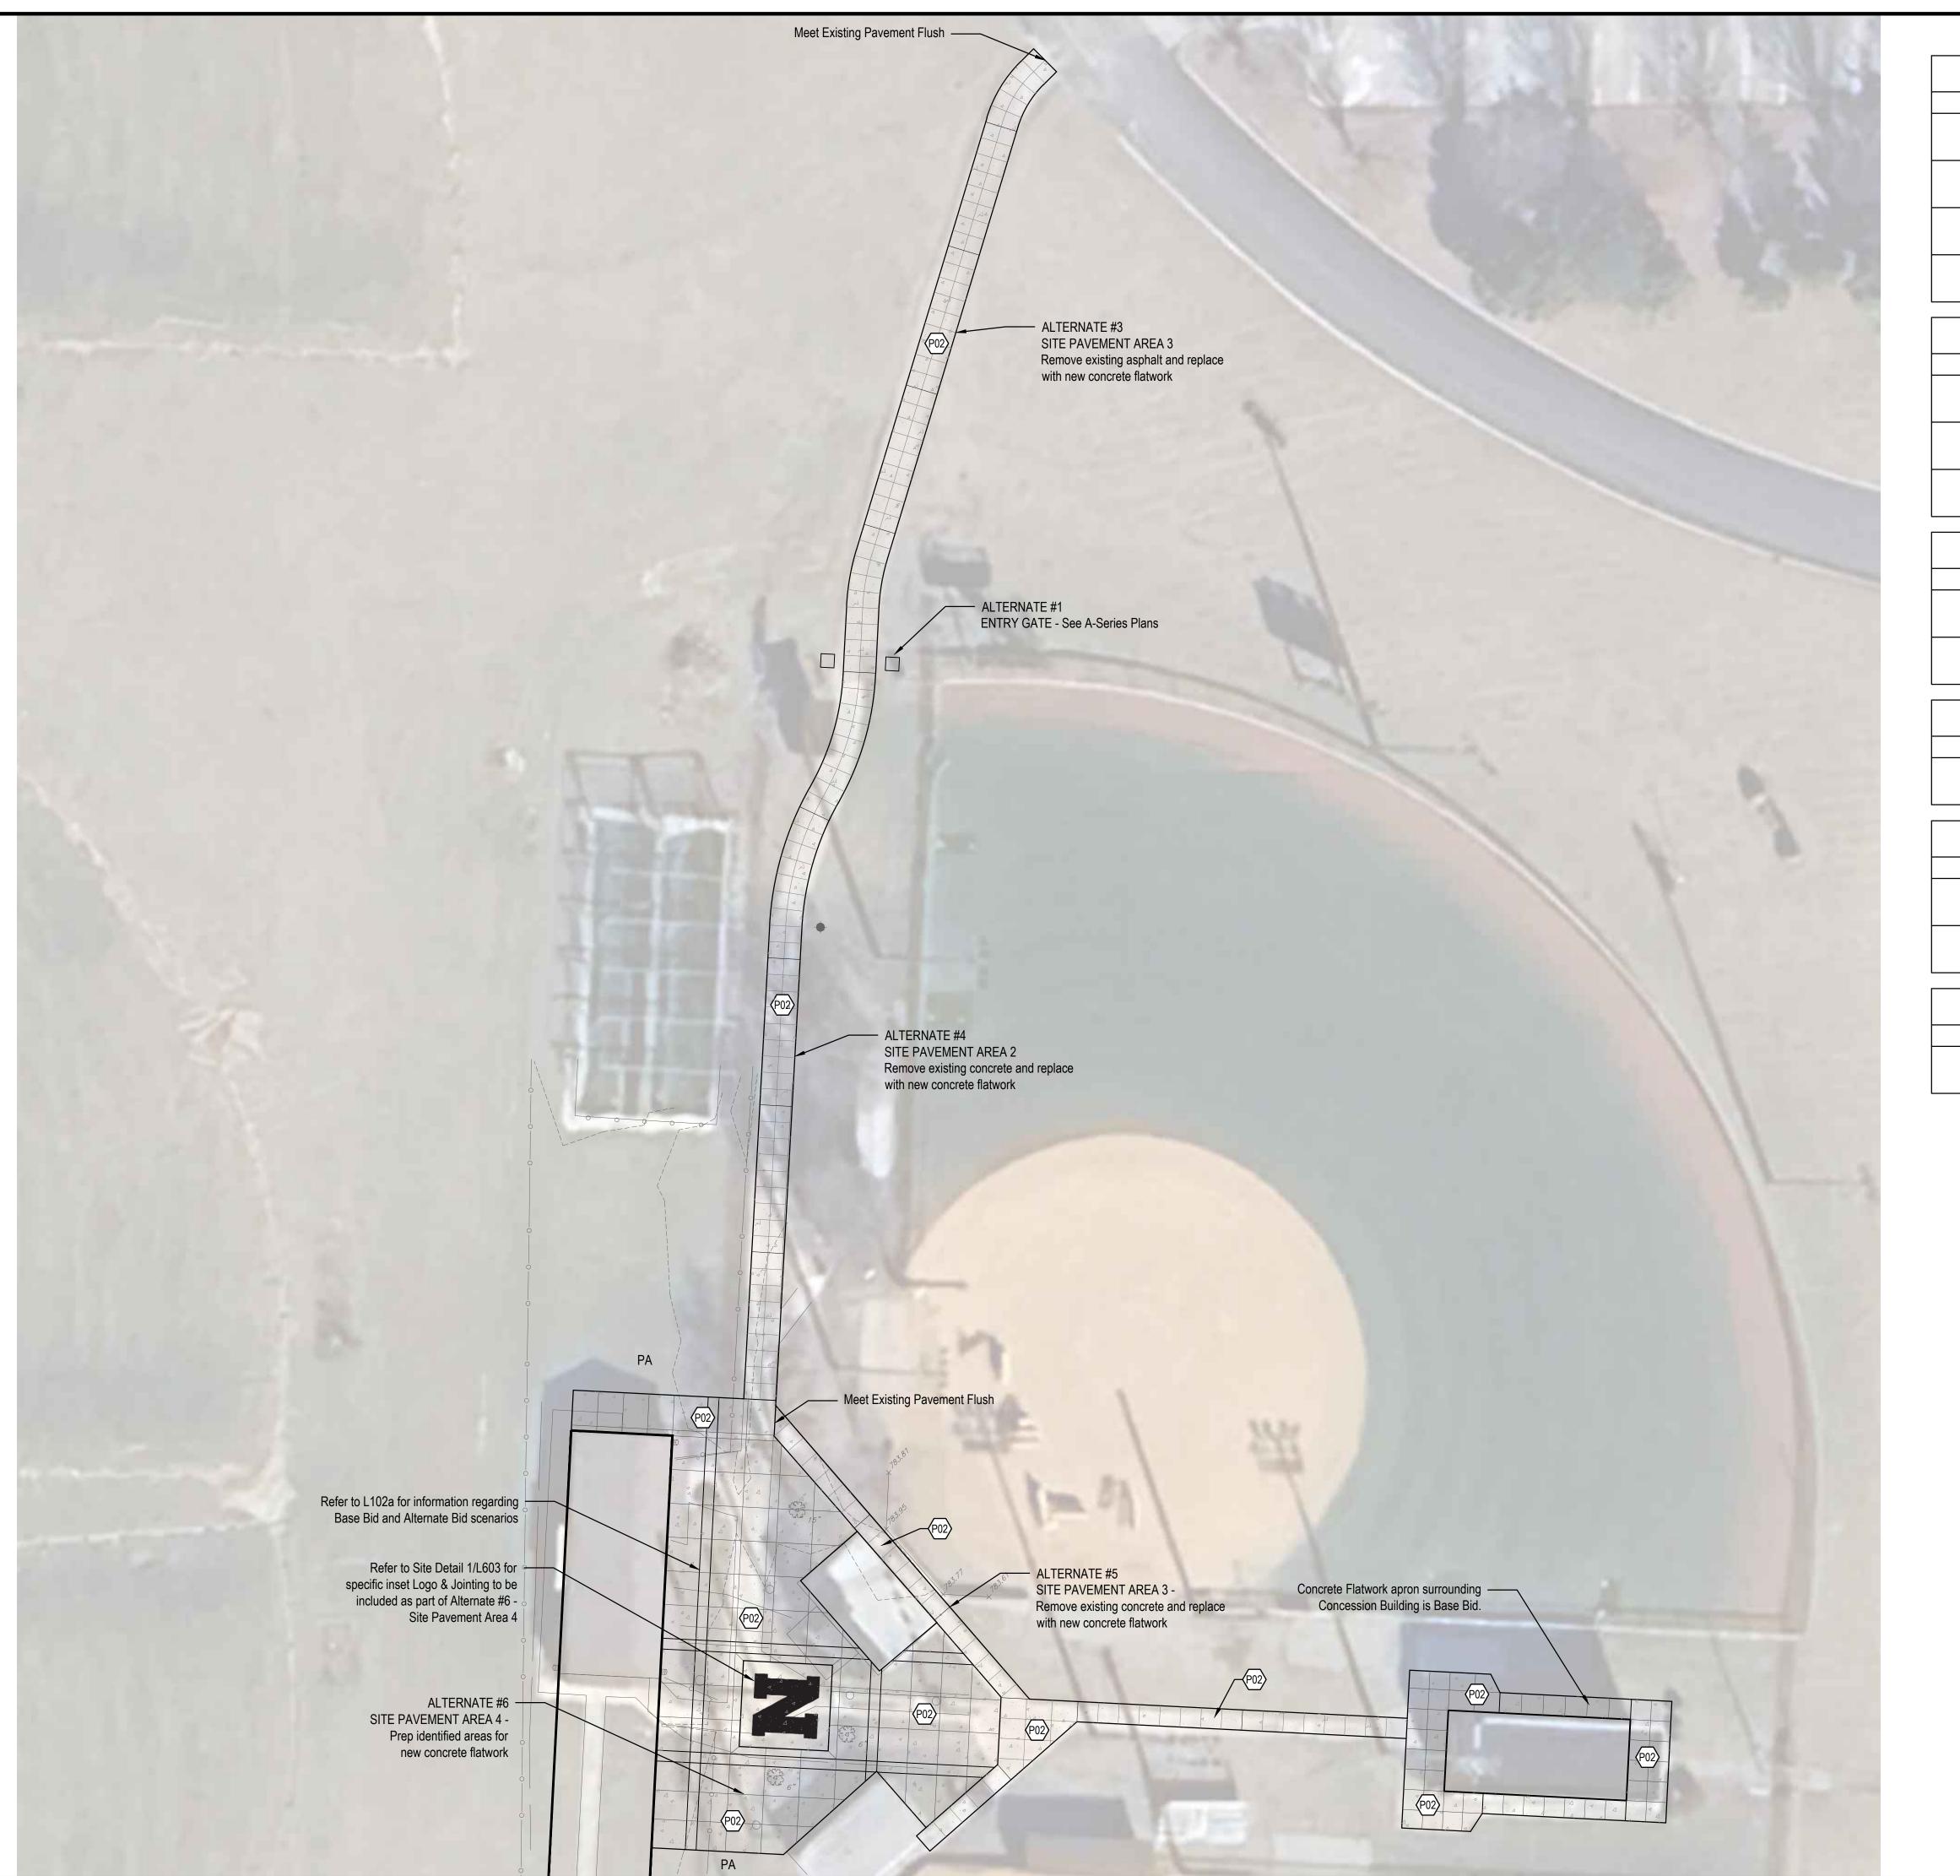

	MATERIAL KEYNOTES
KEY	DESCRIPTION / REFERENCE
(CO1)	CURB, POST REFER TO SITE DETAIL 7/L600 AND SPECIFICATIONS
<b>(</b> C02 <b>)</b>	CURB, INTEGRAL REFER TO SITE DETAIL 8/L600 AND SPECIFICATIONS
<b>(</b> 03 <b>)</b>	CURB, ROLL REFER TO SITE DETAIL 9/L600 AND SPECIFICATIONS
<b>€</b> 04 <b>&gt;</b>	WHEEL STOP REFER TO SITE DETAIL 1/L601 AND SPECIFICATIONS
	FENCING
KEY	DESCRIPTION / REFERENCE
(F01)	6' HEIGHT, BLACK PVC COATED CHAINLINK FENCING; REFER TO SPECIFICATIONS
(F02)	20' OPENING WITH 17' WIDE GATE, BLACK ORNAMENTAL FENCE AND GATE; REFER TO SPECIFICATIONS
(F03)	5' WIDE SINGLE-LEAF GATE, BLACK PVC COATED CHAINLINK FENCING; REFER TO SPECIFICATIONS
	MATERIAL KEYNOTES
KEY	DESCRIPTION / REFERENCE
(P01)	ASPHALT, PATCHBACK REFER TO SITE DETAIL 4/L600 AND SPECIFICATIONS
(P02)	CONCRETE, STANDARD DUTY REFER TO SITE DETAIL 1-3/L600 AND SPECIFICATIONS
	RAMPS & STAIRS
KEY	DESCRIPTION / REFERENCE
(R01)	PARALLEL RAMP REFER TO SITE DETAIL 4/L601 AND SPECIFICATIONS
	SIGNAGE
KEY	DESCRIPTION / REFERENCE
<b>(</b> 501 <b>)</b>	ADA ACCESSIBLE PARKING SIGN REFER TO SITE DETAIL3/L601 AND SPECIFICATIONS
\S02\	ACCESSIBLE PARKING STRIPING & SYMBOL REFER TO SITE DETAIL 2/L601 AND SPECIFICATIONS
	PLANTING
KEY	DESCRIPTION / REFERENCE
KEY PA	DESCRIPTION / REFERENCE PLANTED AREA / SEED ALL DISTURBED AREAS

No. 2020-0052 STATE OF EXPIRES 12-31-2025

JT BUILDINGS MATERIALS & NOTES


SCHOOLS OF

NOBLESVILLE

			She	
Description	Addendum #1 Updates			
Date	2025-01-17			
vision	01			

Date: 2025/01/10
Project No: 24-1838
Drawn by: SS
Checked by: FP

These Drawings and Specifications, and all copies thereof are and shall remain the property and copyright of the Landscape Architect. They shall be used only with respect to this Project and are not to be used on any other Project or Work without prior written permission from the Landscape Architect.

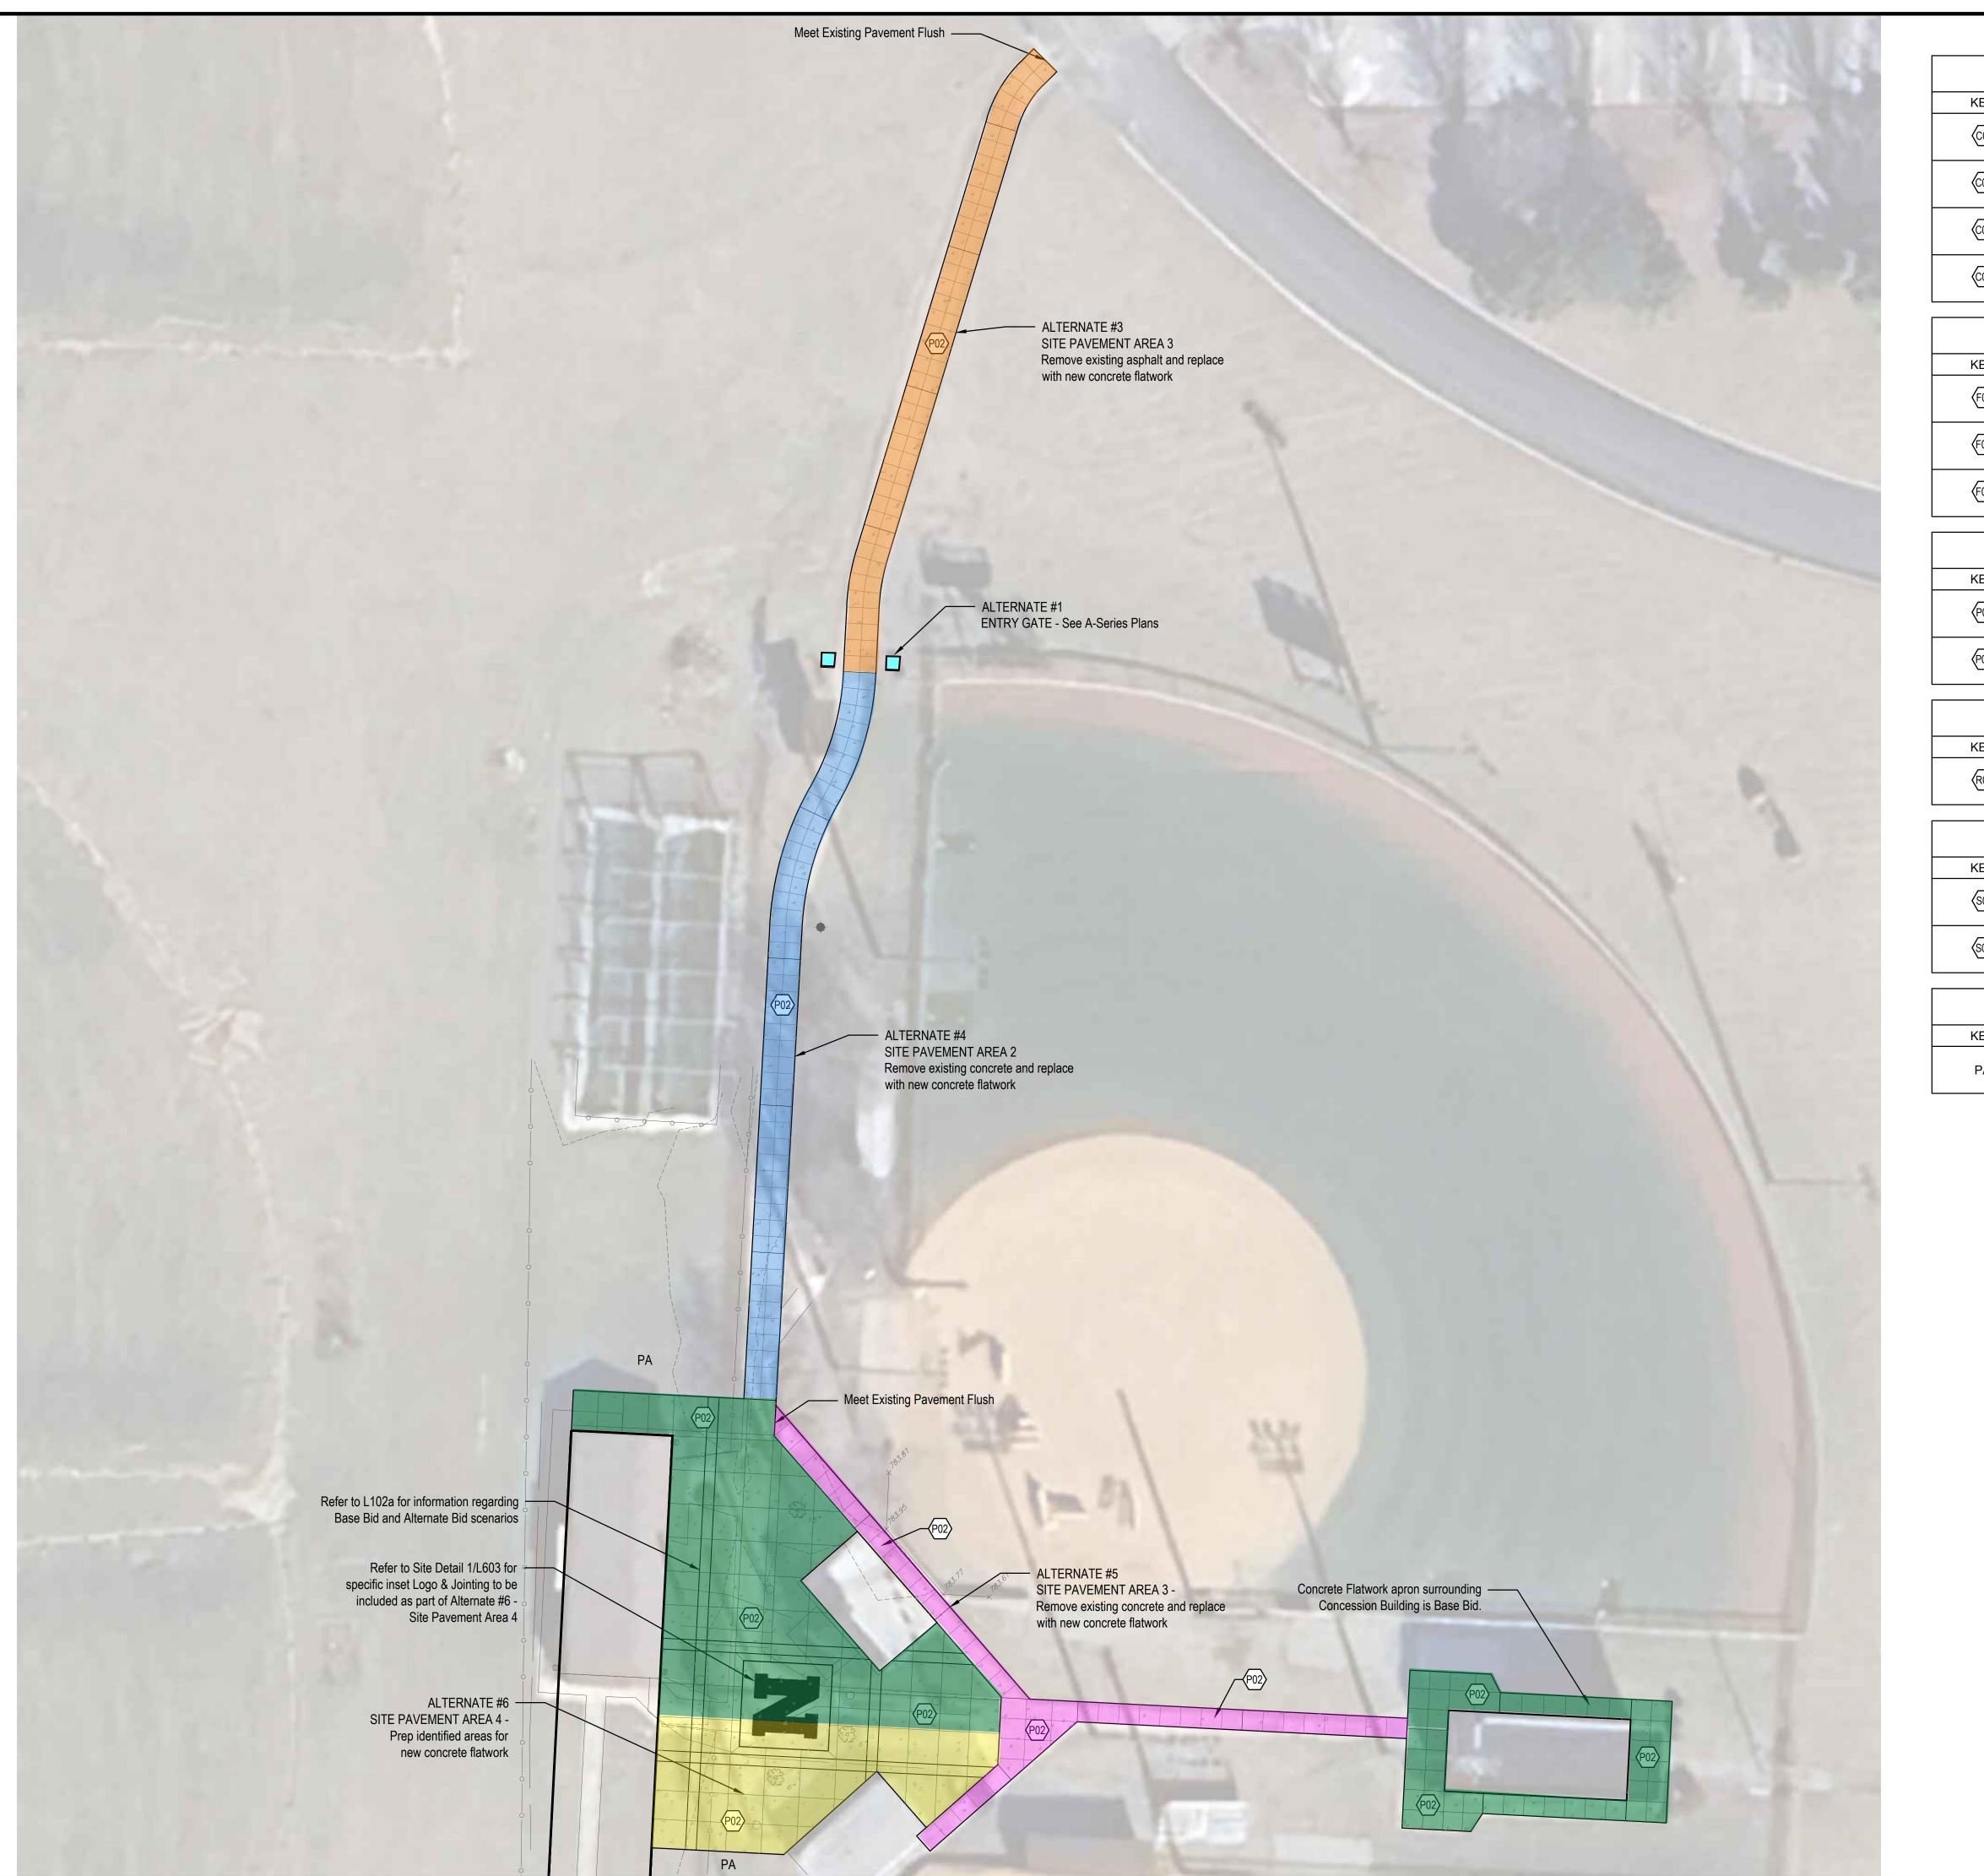

	MATERIAL KEYNOTES
KEY	DESCRIPTION / REFERENCE
(CO1)	CURB, POST REFER TO SITE DETAIL 7/L600 AND SPECIFICATIONS
(02)	CURB, INTEGRAL REFER TO SITE DETAIL 8/L600 AND SPECIFICATIONS
(03)	CURB, ROLL REFER TO SITE DETAIL 9/L600 AND SPECIFICATIONS
(C04)	WHEEL STOP REFER TO SITE DETAIL 1/L601 AND SPECIFICATIONS
	FENCING
KEY	DESCRIPTION / REFERENCE
(F01)	6' HEIGHT, BLACK PVC COATED CHAINLINK FENCING; REFER TO SPECIFICATIONS
(F02)	20' OPENING WITH 17' WIDE GATE, BLACK ORNAMENTAL FENCE AND GATE; REFER TO SPECIFICATIONS
(F03)	5' WIDE SINGLE-LEAF GATE, BLACK PVC COATED CHAINLINK FENCING; REFER TO SPECIFICATIONS
	MATERIAL KEYNOTES
KEY	DESCRIPTION / REFERENCE
(P01)	ASPHALT, PATCHBACK REFER TO SITE DETAIL 4/L600 AND SPECIFICATIONS
(P02)	CONCRETE, STANDARD DUTY REFER TO SITE DETAIL 1-3/L600 AND SPECIFICATIONS
	RAMPS & STAIRS
KEY	DESCRIPTION / REFERENCE
(R01)	PARALLEL RAMP REFER TO SITE DETAIL 4/L601 AND SPECIFICATIONS
	SIGNAGE
KEY	DESCRIPTION / REFERENCE
\so1>	ADA ACCESSIBLE PARKING SIGN REFER TO SITE DETAIL3/L601 AND SPECIFICATIONS
<b>(</b> S02 <b>)</b>	ACCESSIBLE PARKING STRIPING & SYMBOL REFER TO SITE DETAIL 2/L601 AND SPECIFICATIONS
	PLANTING
KEY	DESCRIPTION / REFERENCE
KEY PA	PLANTED AREA / SEED ALL DISTURBED AREA

No. 2020-0052 STATE OF EXPIRES 12-31-2025

JT BUILDINGS SCHOOLS OF


NOBLESVILLE


ALTERNATE DIAGRAMMING SITE 

Description	Addendum #1 Updates			
Date	2025-01-17			
Revision	10			

Date: 2025/01/10
Project No: 24-1838
Drawn by: SS
Checked by: FP


These Drawings and Specifications, and all copies thereof are and shall remain the property and copyright of the Landscape Architect. They shall be used only with respect to this Project and are not to be used on any other Project or Work without prior written permission from the Landscape Architect.

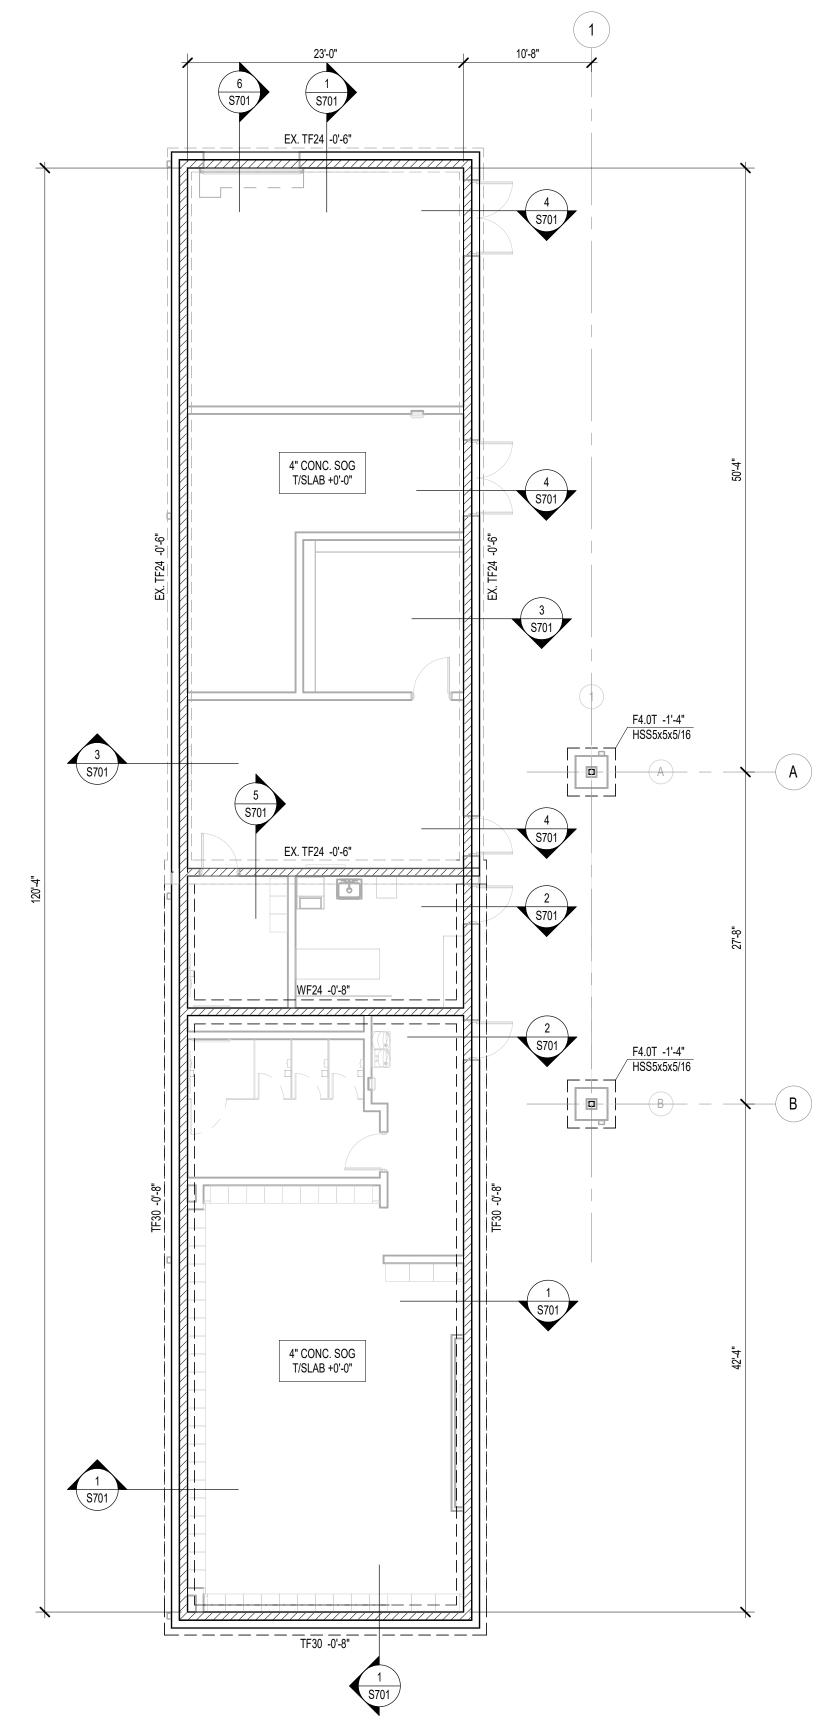

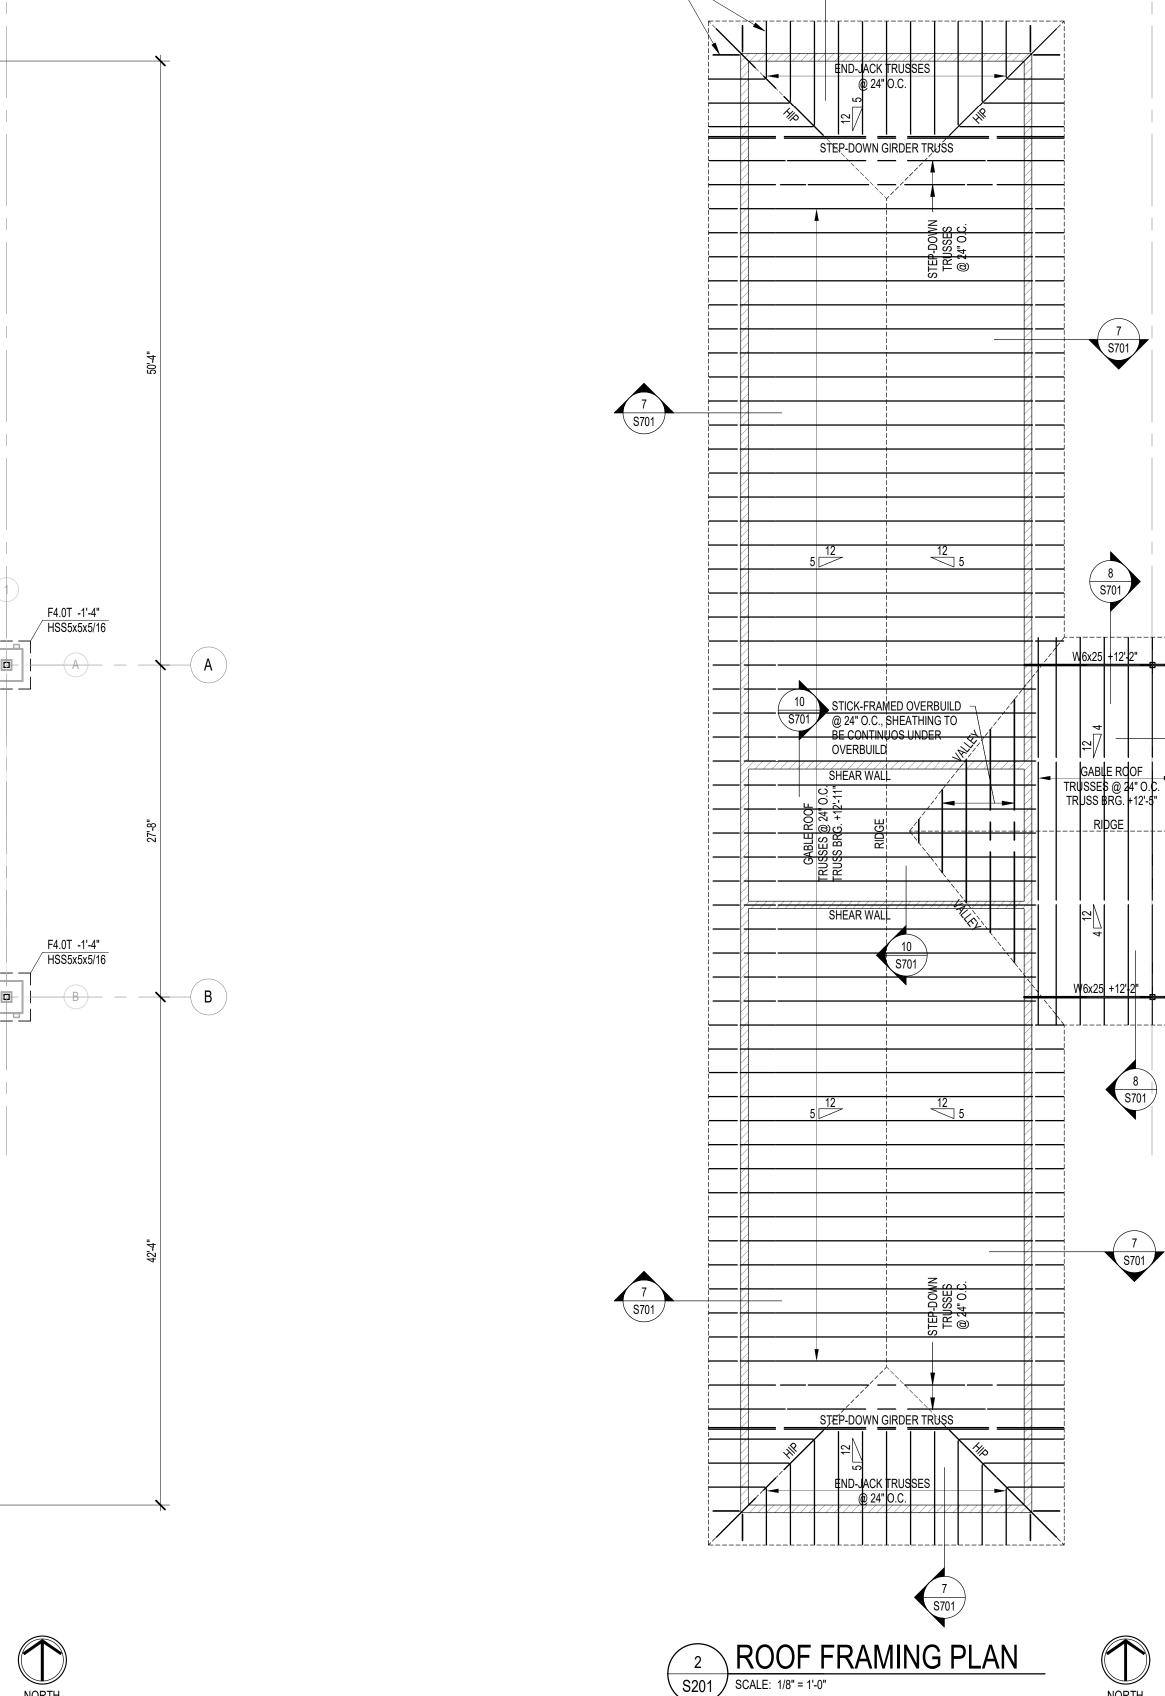

STANDARD CORNER

SET, TYP.

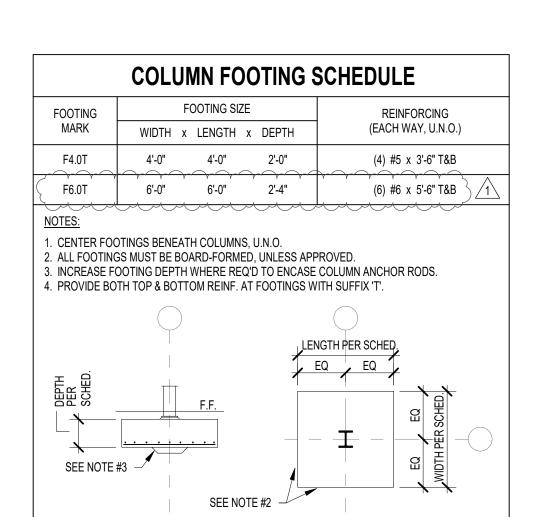

WALL FOOTING SCHEDULE

4. PROVIDE BOTH TOP & BOTTOM REINF. AT FOOTINGS DENOTED WITH SUFFIX 'T' ON PLAN.

LONGITUDINAL

(2) #5 x CONTINUOUS

2'-8" (3) #5 x CONTINUOUS T&B | #4 x 2'-0" @ 96" O.C. T&B

FOOTING SIZE

WF24 2'-0"

TF30

WIDTH DEPTH

1. CENTER FOOTINGS BENEATH WALLS, U.N.O.


3. LAP FOOTING REINF. A MIN. OF 30 BAR DIAMETERS.

2. REF. DETAIL 9/S401 FOR TYP. CONSTRUCTION JOINT DETAIL.


FOOTING REINFORCING

TRANSVERSE

#4 x 1'-6" @ 96" O.C.

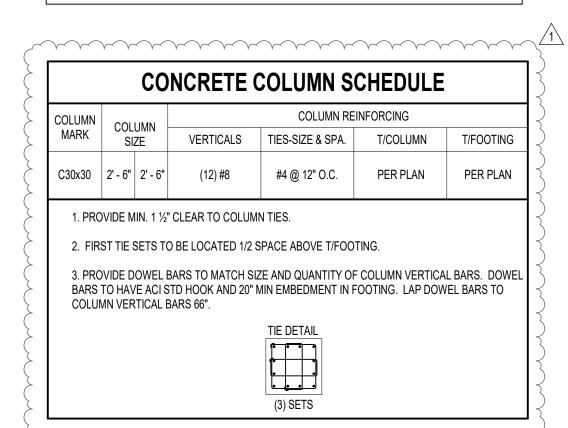


munimunimunimunimi

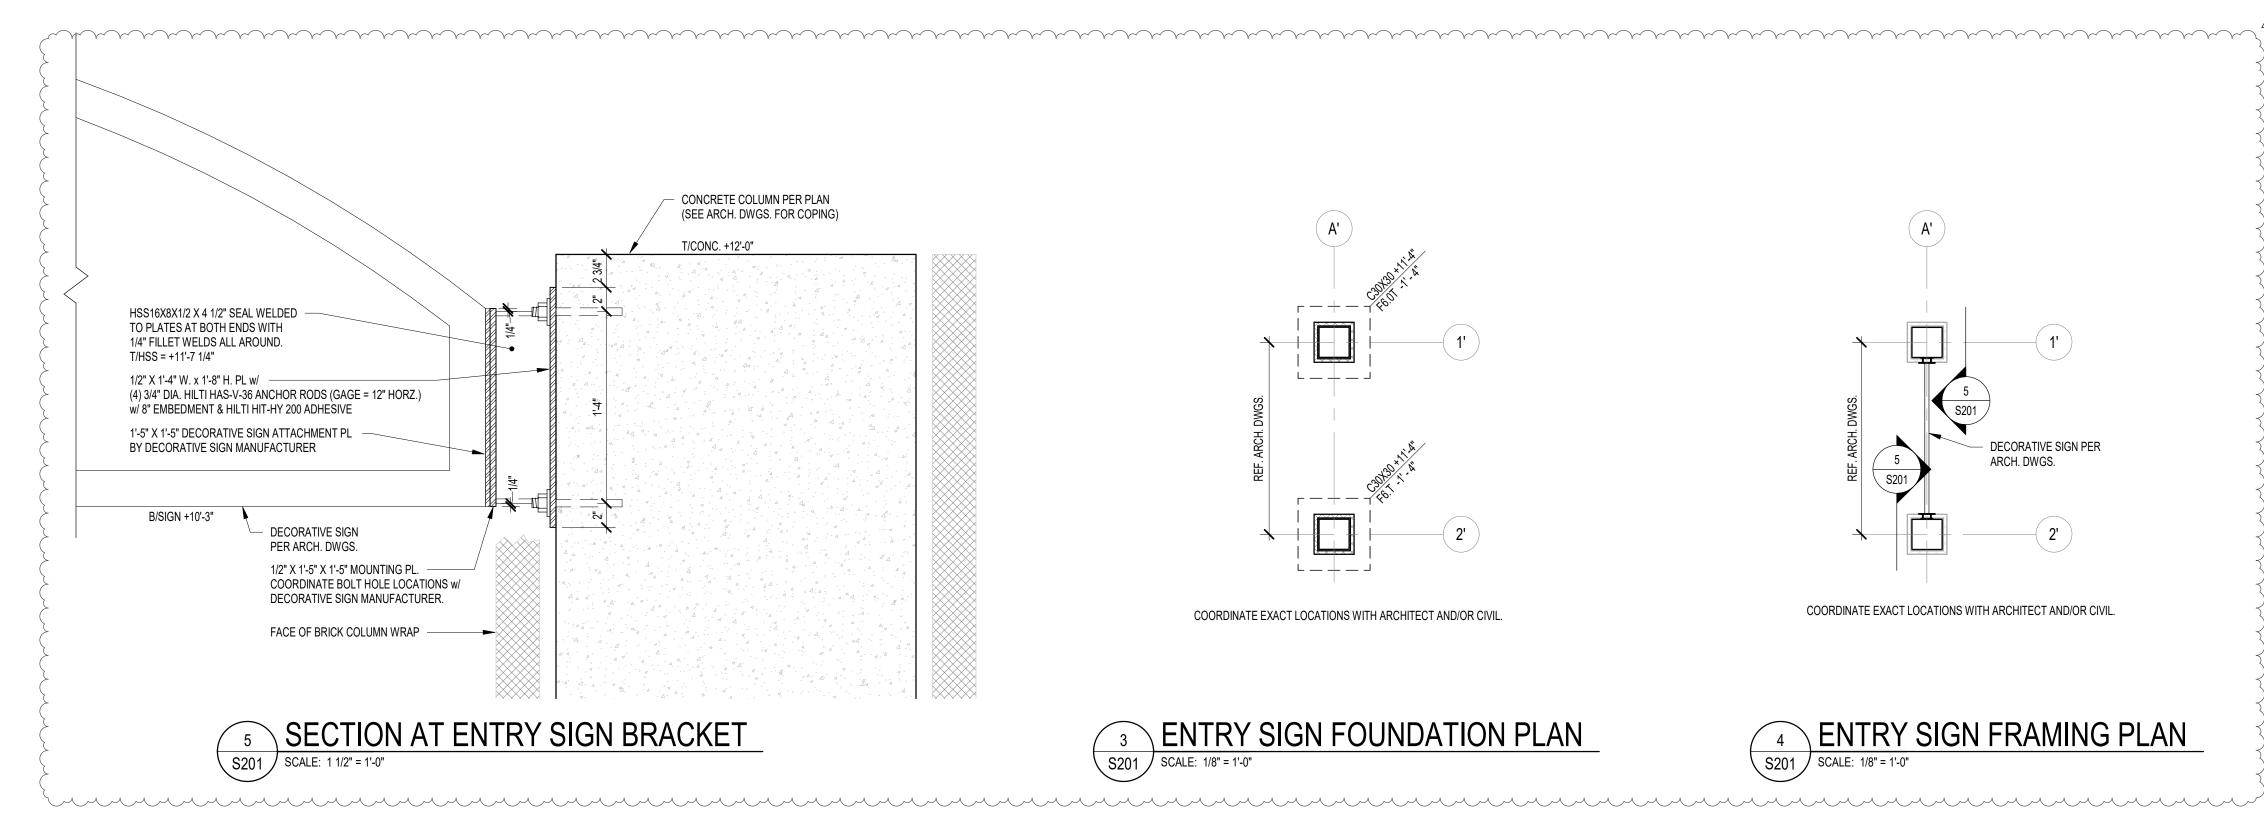

**FOUNDATION PLAN** 

S201 SCALE: 1/8" = 1'-0"

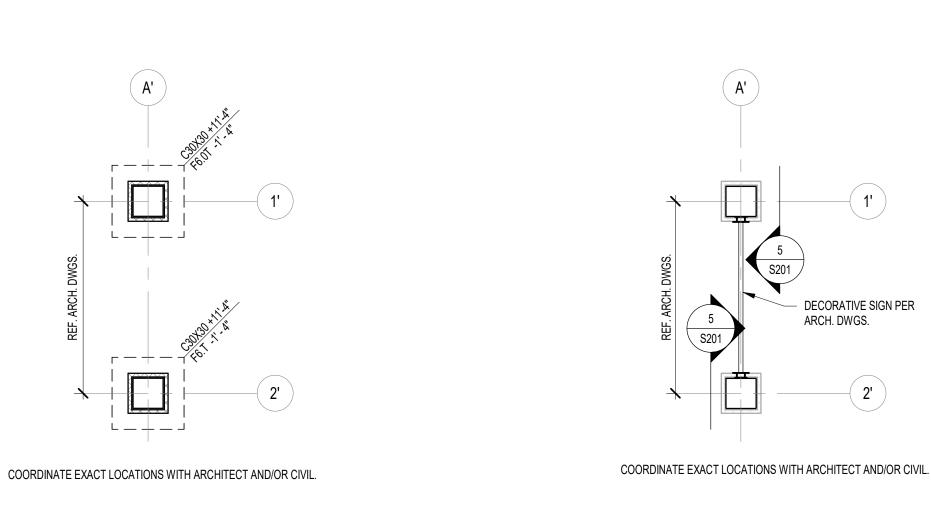





DECORATIVE SIGN PER

ARCH. DWGS.

#### FOUNDATION PLAN NOTES

- 1. REF. S001 FOR STRUCTURAL NOTES, DESIGN DATA, SCHEDULES & LEGENDS. 2. REF. THE S400 SERIES FOR TYPICAL FOUNDATION AND MASONRY DETAILS. 3. ALL CONTRACTORS ARE REQUIRED TO COORDINATE THEIR WORK WITH ALL DISCIPLINES TO AVOID CONFLICTS. THE MECHANICAL, ELECTRICAL, AND PLUMBING ASPECTS ARE NOT IN THE SCOPE OF THESE DRAWINGS.
- THEREFORE, ALL REQUIRED MATERIALS AND WORK MAY NOT BE 4. ALL ELEVATIONS ARE REFERENCED FROM THE FIRST FLOOR FIN. FLOOR
- ELEVATION +0'-0". VERIFY ELEVATION WITH CIVIL DWGS. 5. <u>ALL WALLS SHALL BE LAID OUT FROM THE ARCHITECTURAL DRAWINGS.</u> 6. REF. ARCH. DRAWINGS. FOR ALL DIMENSIONS NOT SHOWN. CONTRACTOR
- IMMEDIATELY NOTIFY ARCHITECT/ENGINEER OF ANY DISCREPANCIES. 7. COORDINATE EXACT SIZE & LOCATION OF ALL MECHANICAL OPENINGS IN FDN. WALLS WITH THE MECHANICAL, ELECTRICAL & PLUMBING CONTRACTORS.

SHALL VERIFY ALL DIMENSIONS PRIOR TO CONSTRUCTION AND

- 8. NOTE: PERIMETER FOOTINGS SHALL BE LOWERED AND/OR SLEEVED TO PASS BELOW PLUMBING LINES (E.G., SANITARY & STORM LINES, WATER LINES, ETC.) SHOWN ON THE PLUMBING DRAWINGS. PROVIDE FOOTING STEPS AS REQUIRED PER THE TYPICAL DETAILS ON \$401.
- 9. ALL SLAB RECESSES SHALL BE LOCATED PER THE ARCHITECTURAL DRAWINGS. COORDINATE DEPTHS OF ALL SLAB RECESSES WITH THE ARCHITECTURAL DRAWINGS AND/OR THE FLOORING SUPPLIER.
- 10. PROVIDE CMU REINFORCING AS NOTED ON PLANS & SECTIONS. IF NOT SHOWN ELSEWHERE, MINIMUM CMU WALL REINFORCING TO BE #5 VERTS @ 48" OC. PROVIDE OPEN-CORE BOND BEAMS AT TOPS OF WALLS, AT CHANGES IN CMU THICKNESS, AND WHERE INDICATED ON PLANS & SECTIONS (10'-0" OC MAX VERTICAL SPACING). PROVIDE 1/2 OF INTERRUPTED VERTICALS AT JAMBS OF OPENINGS AND PROVIDE ADDITIONAL VERT'S. AT ENDS OF WALLS. 11. COORDINATE REINFORCING DOWELS FOR CMU VERTICAL REINFORCING
- 12. GROUT ALL CORES OF CMU SOLID BELOW FIN. FLOOR ELEVATION. 13. PROVIDE THICKENED SLAB UNDER ALL INTERIOR CMU WALLS WITHOUT FOOTINGS. SEE S401 FOR THICKENED SLAB DETAIL. REF. THE ARCHITECTURAL DRAWINGS FOR LOCATIONS OF CMU WALLS.

WITH REINF. NOTED ON PLANS & SECTIONS.

- 14. ALL FOOTINGS SHALL BEAR ON APPROVED SOIL. UNDERCUT AS REQ'D. TO SUITABLE BEARING MATERIAL AS DETERMINED BY THE GEOTECHNICAL TESTING AGENCY. REF. TYPICAL FOOTING UNDERCUT DETAILS ON S402. 15. PROVIDE CONTROL/CONTRACTION JOINTS IN SLABS ON GRADE (REF. TYPICAL DETAILS ON S401). ALL JOINTS IN SLABS TO RECEIVE THIN OR THICK-SET TERRAZZO, CERAMIC OR PORCELAIN TILE, VINYL-COMPOSITION TILE (VCT) OR VINYL SHEET GOODS, EPOXY OR SIMILAR THIN-FILM FINISH FLOORING SHALL BE CAREFULLY COORDINATED WITH THE FLOORING CONTRACTOR. THE CONTRACTOR SHALL SUBMIT SLAB JOINT LAYOUT TO ARCHITECT/ENGINEER FOR REVIEW PRIOR TO PLACING SLABS.
- PERMIT (I.E. WHERE THE BANKS OF THE EXCAVATION WILL HOLD WITHOUT CAVING AND SLOUGHING). HOWEVER, THE PLAN DIMENSION OF EARTH- FORMED FOOTINGS MUST BE INCREASED BY 2" ALONG ALL EDGES TO ACCOUNT FOR INACCURACIES ASSOCIATED WITH EARTH-FORMING (I.E. 2'-0" WIDE WALL FOOTINGS SHALL BE 2'-4" WIDE AND 5'-0" SQUARE COLUMN FOOTINGS SHALL BE 5'-4" SQUARE).

16. EARTH-FORMED FOOTINGS ARE ACCEPTABLE WHERE SOIL CONDITIONS

- 17. REF. ARCHITECTURAL DWGS. FOR MASONRY CONTROL & EXPANSION JOINT LOCATIONS.
- 18. ALL EXISTING CONSTRUCTION SHOWN IN PLAN AND/OR SECTION WAS DERIVED FROM EXISTING DWGS. AND SHALL BE FIELD VERIFIED. IF ANY DISCREPANCIES ARE DISCOVERED BETWEEN INFORMATION SHOWN ON THE DRAWINGS AND ACTUAL CONDITIONS, IMMEDIATELY CONTACT THE ARCHITECT/ENGINEER FOR DIRECTION BEFORE PROCEEDING WITH WORK. 19. PLAN LEGEND:

DENOTES FIN. FLOOR DENOTES TOP OF FTG, SLAB, PIER, ETC. DENOTES BOTTOM OF FTG, GRADE BEAM, ETC. CONTROL/CONTRACTION JOINT DENOTES EXISTING CONSTRUCTION DENOTES TRENCH FOOTING MARK & TOP OF FOOTING ELEVATION (REF. WALL FTG

DENOTES WALL FOOTING WITH STEPS. REF. TYP. DETAIL ON S401 \_ \_ \_ \_ \_ \_ \_


> DENOTES CMU FOUNDATION WALL DENOTES CMU FDN. WALL HELD DOWN AT DENOTES THICKENED SLAB UNDER INTERIOR

NON-LOAD BEARING CMU WALLS

DENOTES SLAB ON GRADE THICKNESS & T/SLAB ELEVATION. ALL SLABS ON GRADE TO BE PLACED ON 6" MIN. COMPACTED GRANULAR FILL & VAPOR BARRIER/RETARDER PER SPECS. PROVIDE THE

─ STEEL COLUMN

FOLLOWING WELDED WIRE FABRIC REINFORCING: 4" SLAB: 6x6-W1.4xW1.4 WWF 6" SLAB: 6x6-W2.9xW2.9 WWF

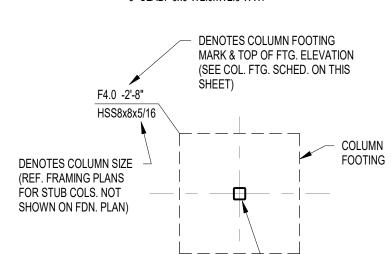

#### FRAMING PLAN NOTES

4" CONC. SOG

- 1. REF. S001 FOR STRUCTURAL NOTES, DESIGN DATA, SCHEDULES & LEGENDS. 2. REF. THE S400 SERIES FOR TYPICAL FRAMING AND MASONRY DETAILS. 3. ALL CONTRACTORS ARE REQUIRED TO COORDINATE THEIR WORK WITH ALL DISCIPLINES TO AVOID CONFLICTS. THE MECHANICAL, ELECTRICAL, AND PLUMBING ASPECTS ARE NOT IN THE SCOPE OF THESE DRAWINGS.
- 4. ALL ELEVATIONS ARE REFERENCED FROM THE FIRST FLOOR FIN. FLOOR ELEVATION +0'-0". VERIFY ELEVATION WITH CIVIL DWGS.

IMMEDIATELY NOTIFY ARCHITECT/ENGINEER OF ANY DISCREPANCIES.

THEREFORE, ALL REQUIRED MATERIALS AND WORK MAY NOT BE INDICATED.

- 5. <u>ALL WALLS SHALL BE LAID OUT FROM THE ARCHITECTURAL DRAWINGS.</u> 6. REF. ARCH. DRAWINGS. FOR ALL DIMENSIONS NOT SHOWN. CONTRACTOR SHALL VERIFY ALL DIMENSIONS PRIOR TO CONSTRUCTION AND
- 7. COORDINATE EXACT SIZE & LOCATION OF ANY MECHANICAL OPENINGS IN FLOOR SLAB, ROOF DECK, OR WALLS WITH THE MEP CONTRACTOR(S). LOCATION & SIZE OF ALL DUCT OPENINGS, GRILLES, ETC. SHALL BE
- VERIFIED PRIOR TO CONSTRUCTION. 8. ALL ELEVATIONS SHOWN ON PLAN INDICATE TOP OF STEEL BEAM UNLESS NOTED OTHERWISE.
- 9. PROVIDE CMU REINFORCING AS NOTED ON PLANS. IF NOT SHOWN ON PLANS. MINIMUM CMU WALL REINFORCING TO BE #5 VERTS @ 48" O.C. PROVIDE OPEN-CORE BOND BEAMS AT TOPS OF WALLS, AT CHANGES IN CMU THICKNESS, AND WHERE INDICATED ON PLANS & SECTIONS (10'-0" O.C. MAX VERTICAL SPACING). PROVIDE 1/2 OF INTERRUPTED VERTICALS AT JAMBS OF OPENINGS AND PROVIDE ADDITIONAL VERT'S. AT ENDS OF WALLS.
- 10. ALL MASONRY BOND BEAMS, OTHER THAN BOND BEAM LINTELS OVER OPENINGS, SHALL BE "OPEN-CORE" BOND BEAMS TO ALLOW VERTICAL REINFORCING TO PASS THROUGH, UNLESS NOTED OTHERWISE. 11. REF. ARCH. DWGS. FOR MASONRY CONTROL & EXPANSION JOINT LOCATIONS.
- 12. PLAN LEGEND: DENOTES FIN. FLOOR T/'X'

DENOTES TOP OF STEEL, SLAB, ETC. DENOTES BOTTOM OF LINTEL, ETC. DENOTES EXISTING CONSTRUCTION



202


HOOL SOFTE BUILDING plesville, IN 46060

SCOPE DRAWINGS: proper execution and completion of the work.


> REVISIONS: Addendum 1 1/17/2025

ISSUE DATE | DRAWN BY | CHECKED BY 12/20/2024 MDL

DRAWING TITLE: FOUNDATION & **ROOF FRAMING PLANS** 

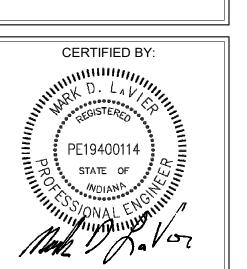

DRAWING NUMBER

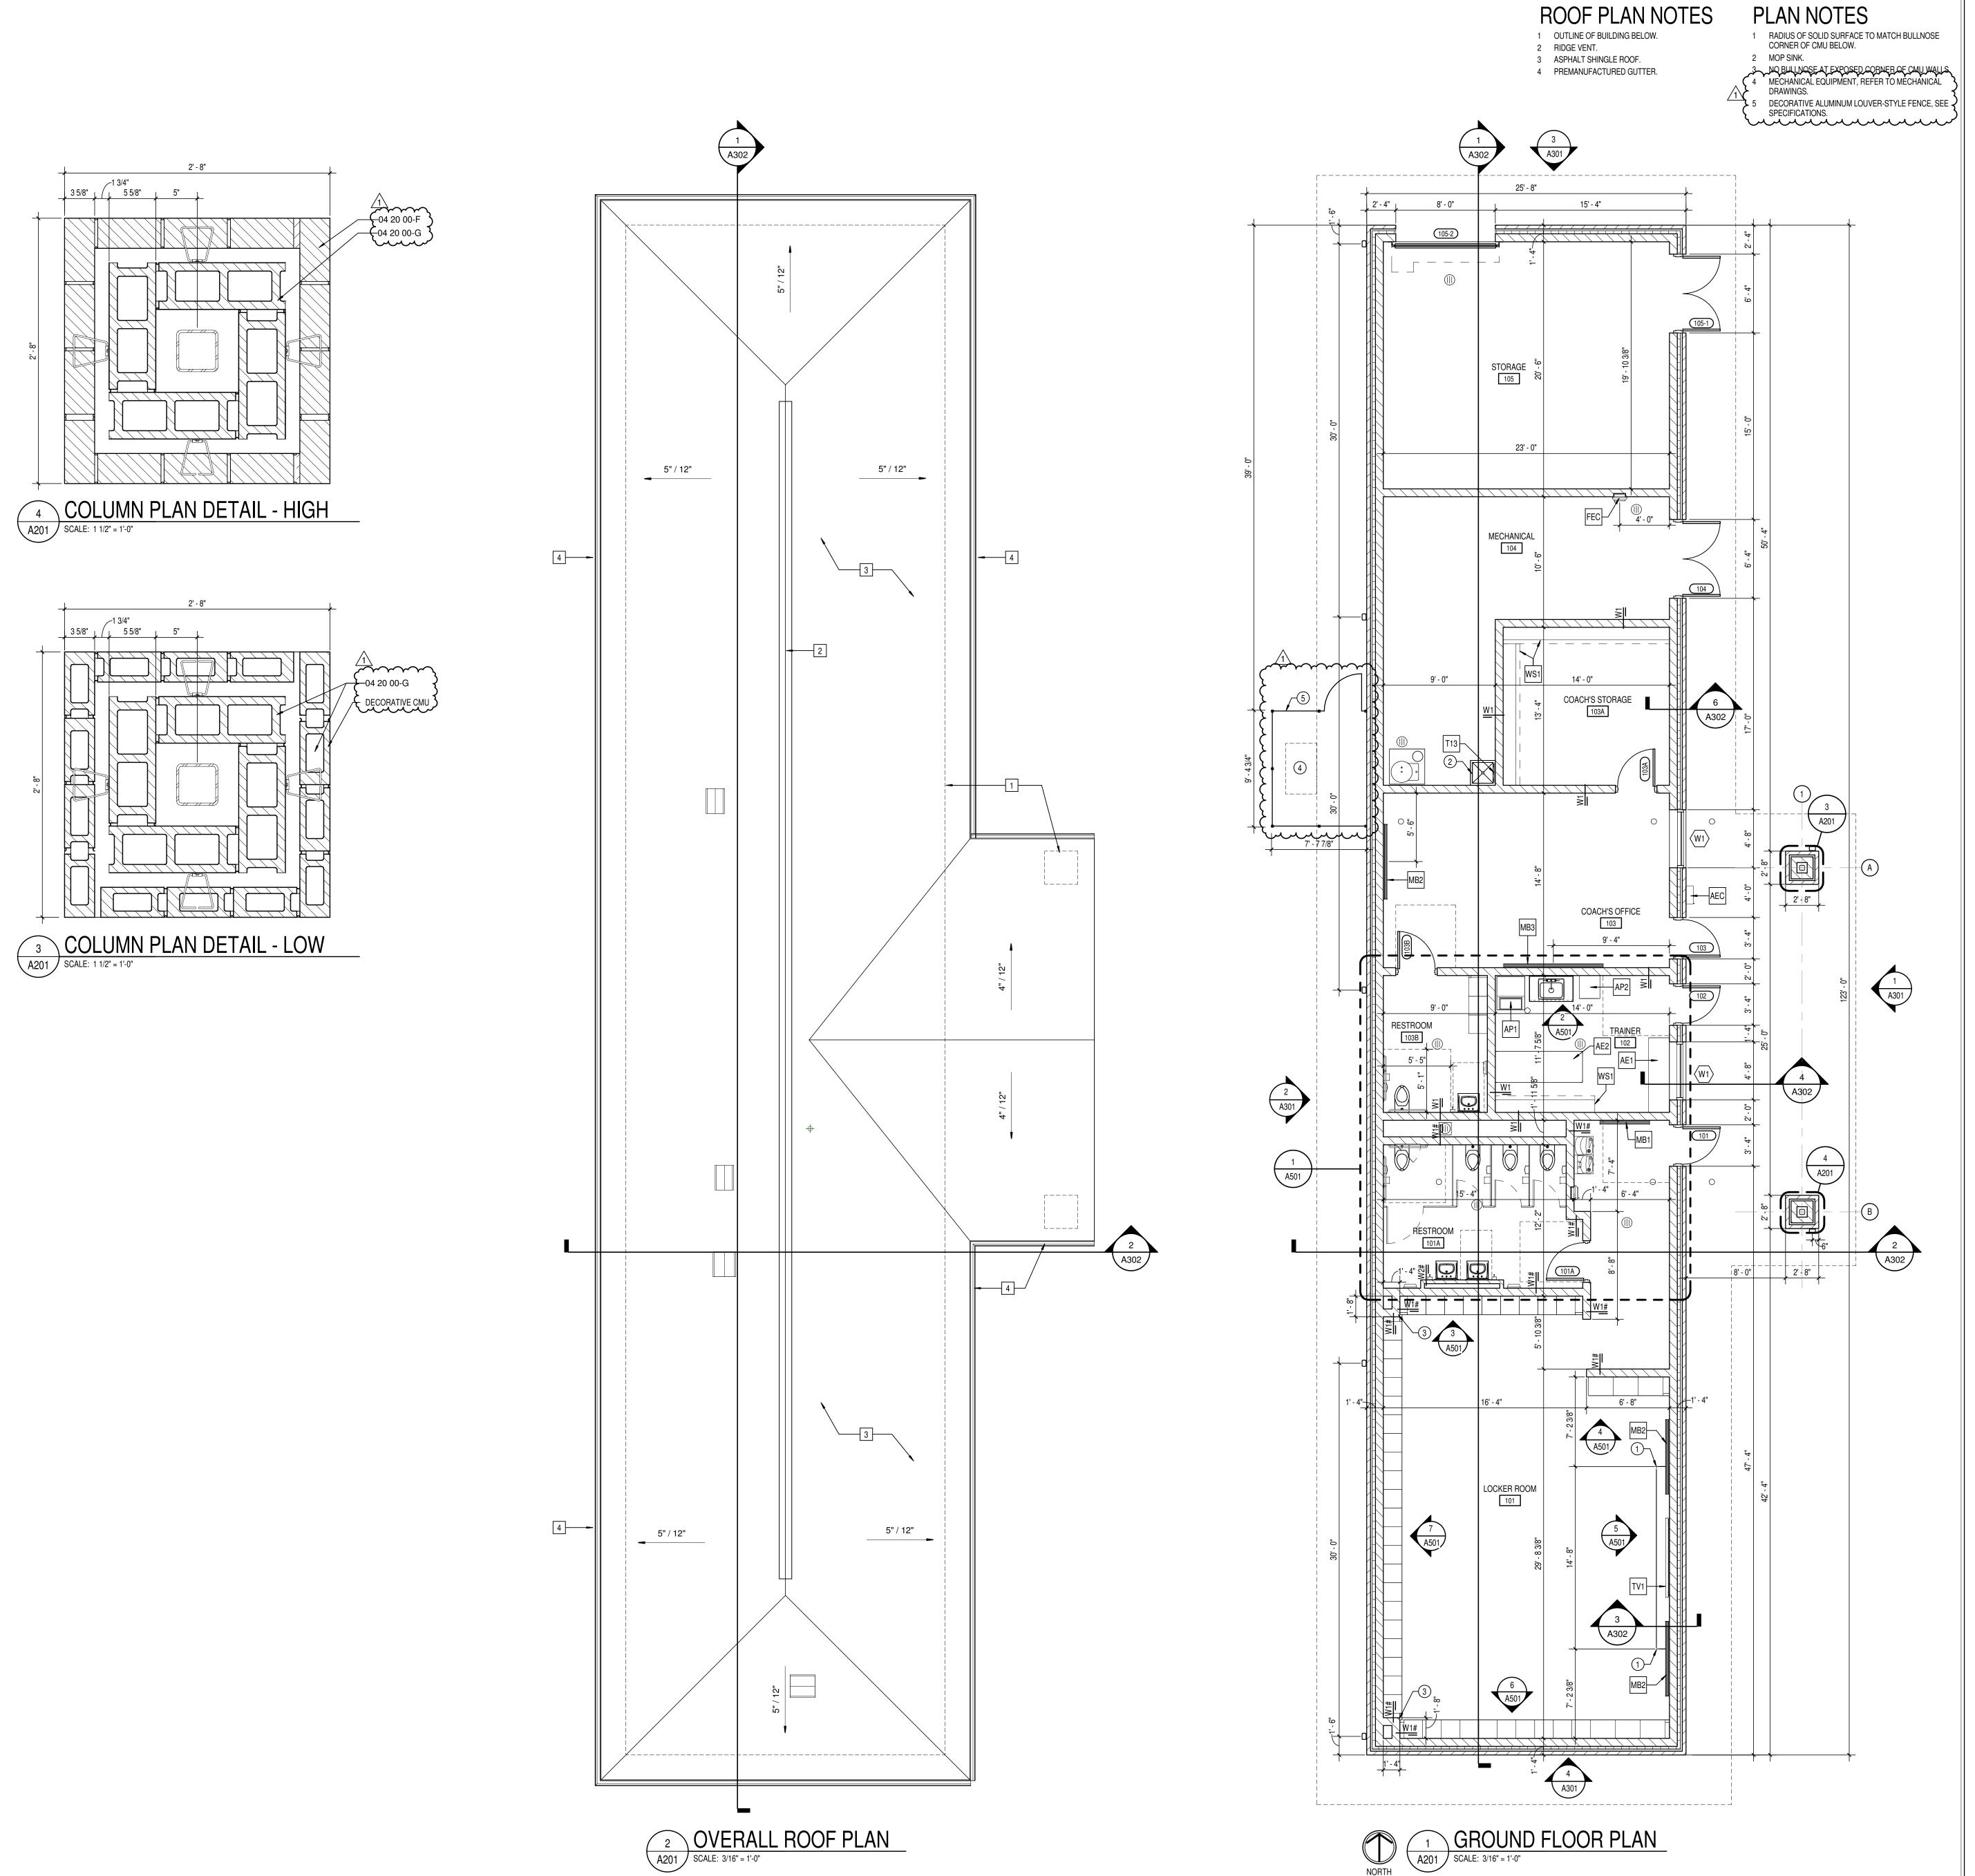

#### LIFE SAFETY INFORMATION

- INDIANA BUILDING CODE 2014
- (2012 INTERNATIONAL BUILDING CODE & STATE AMENDMENTS) INDIANA FIRE CODE - 2014 (2012 INTERNATIONAL FIRE CODE & STATE AMENDMENTS)
- INDIÀNA ELECTRICAL CODE 2009 (2008 NATIONAL ELECTRICAL CODE & STATE AMENDMENTS) INDIANA MECHANICAL CODE - 2014 (2012 INTERNATIONAL MECHANICAL CODE & STATE AMENDMENTS) INDIANA PLUMBING CODE - 2012 (2006 INTERNATIONAL PLUMBING CODE & STATE AMENDMENTS) INDIANA ACCESSIBILITY CODE - 2014 I.B.C., CHAP. 11 (ANSI A117.1-2009)
- INDIANA ENERGY CONSERVATION CODE 2011 (ASHRAE 90.1, 2007 EDITION) NFPA 10 - 2010 EDITION, PORTABLE FIRE EXTINGUISHERS INDIANA GENERAL ADMINISTRATIVE RULES (675 IAC 12) AMERICANS WITH DISABILITIES ACT (FEDERAL LAW) JULY 26, 1992

#### **BUILDING INFORMATION**

NEW/TOTAL AREA: 3,157 SQUARE FEET BUILDLING CONSTRUCTION TYPE: V-B, NON-SPRINKLERED BUILDING USE GROUP CLASSIFICATION: B

#### GENERAL NOTES

- A. COORDINATE THE WORK OF EACH TRADE WITH THE WORK OF ALL WORK IS TO BE COMPLETED IN STRICT ACCORDANCE WITH ALL APPLICABLE CODES, ORDINANCES, RULES, REGULATIONS AND STANDARDS INCLUDING, BUT NOT LIMITED TO THOSE LISTED ON THE COVER SHEET. ALL APPLICABLE RULES & REGULATIONS ARE TO BE
- THE MOST CURRENT ADOPTED EDITIONS. ALL WORK SHALL BE IN ACCORDANCE WITH THE BEST QUALITY STANDARDS OF THE TRADE, AND SHALL CONFORM WITH THE LATEST EDITION OF ALL FEDERAL, STATE, AND LOCAL CODES AND STANDARDS. THE SAME ARE MADE A PART OF THESE CONTRACT DOCUMENTS, AS IF REPEATED HEREIN.
- CONTRACT DOCUMENTS CONSIST OF BOTH THE PROJECT MANUAL AND DRAWINGS, AND BOTH ARE INTENDED TO BE COMPLEMENTARY. ANYTHING APPEARING ON EITHER MUST BE EXECUTED THE SAME AS IF SHOWN ON BOTH. CONSTRUCTION DOCUMENTS SHALL BE FOLLOWED AS CLOSELY AS

POSSIBLE, HOWEVER, SYSTEMS HAVE BEEN SHOWN

PROVIDE ADDITIONAL ITEMS AS REQUIRED TO PROVIDE A COMPLETE AND COORDINATED SYSTEM. CONTRACTOR SHALL PROVIDE ANY AND ALL TEMPORARY UTILITY SERVICE REQUIRED TO CONSTRUCT THE WORK. CONTRACTOR MAY EXTEND SERVICES FROM EXISTING LOCATIONS TO WHERE THEY ARE REQUIRED. REMOVE TEMPORARY UTILITIES AND RELATED

DIAGRAMMATICALLY AND IN SOME CASES, ENLARGED FOR CLARITY.

- EXTENSIONS AS SOON AS PRACTICABLE. RESTORE ALL AFFECTED AREAS TO ORIGINAL CONDITION. G. STORE VOLATILE OR FLAMMABLE LIQUIDS IN UL LISTED FIRE
- H. CONTRACTOR SHALL BE SOLELY RESPONSIBLE FOR THE SECURITY OF ALL STORED MATERIALS AND EQUIPMENT INSIDE OR OUTSIDE THE BUILDING.
- CONTRACTOR SHALL FURNISH NECESSARY TEMPORARY PROTECTION FROM WEATHER TO PROTECT INTERIOR OF BUILDING FROM ELEMENTS OF WEATHER AT ALL TIMES. CONTRACTOR RESPONSIBLE FOR TRAFFIC PROTECTION DURING CONSTRUCTION. AREAS OF WORK SUBJECTED TO TRAFFIC BY
- VARIOUS TRADES SHALL BE PROTECTED BY TEMPORARY WALK FIELD VERIFY EXISTING CONDITIONS AND DIMENSIONS PRIOR TO THE COMMENCEMENT OF WORK. DISCREPANCIES BETWEEN THE DOCUMENTS AND THE ACTUAL CONDITIONS SHALL BE BROUGHT TO THE ATTENTION OF THE ARCHITECT PRIOR TO THE COMMENCEMENT
- ALL DIMENSIONS ARE FROM CENTERLINE OF STRUCTURE. FINISH FACE OF WALL, FACE OF MASONRY, OR FACE OF EXISTING. ANY DIMENSIONS NOT SHOWN OR DEEMED QUESTIONABLE ARE TO BE VERIFIED BY ARCHITECT. DO NOT SCALE DRAWINGS.
- N. REFER TO WALL TYPE SCHEDULE AND NOTES (A201) TO DETERMINE WHICH WALLS DO NOT EXTEND TO STRUCTURE ABOVE. REFER TO PLUMBING PLANS FOR LOCATION OF FLOOR DRAINS.
- WHERE ACCESS PANELS ARE SHOWN IN TOILET ROOM CHASES, FINAL LOCATION SHALL BE COORDINATED WITH OTHER TRADES
- PRIOR TO INSTALLATION. ALL CONCRETE MASONRY UNITS (CMU) SHALL BE LAID RUNNING BOND U.N.O. CMU WALLS THAT DO NOT LAY OUT IN FULL OR HALF
- LENGTHS SHOULD BE BALANCED SO AS NOT TO HAVE ANY PIECES LESS THAN 4" IN SIZE EXPOSED TO VIEW.
- THERE SHALL BE PERIMETER INSULATION CONTINUOUS AROUND THE ENTIRE PERIMETER OF THE BUILDING EXTENDING 2'-0" MINIMUM (R-15 MIN.) HORIZONTAL. PROVIDE MISCELLANEOUS SUPPORT FOR ALL CEILING SUSPENDED
- DOOR AND FRAME NUMBERS CORRESPOND TO ROOM NUMBERS. WHERE MORE THAN ONE DOOR OCCURS IN A ROOM, A SUFFIX HAS
- BEEN ADDED (E.G. A100-1). SEE A500 SERIES DRAWINGS FOR DOOR SCHEDULE AND DETAILS. ALL DOOR FRAMES SHALL BE LOCATED 4" OFF FINISH WALLS OR 4" OFF MASONRY WALLS UNLESS NOTED OTHERWISE.
- ALL GLASS AT INTERIOR DOOR FRAMES, DOOR LITES AND WINDOW FRAMES IS TO BE 1/4" CLEAR TEMPERED GLASS UNLESS NOTED
- W. ALL SLAB-ON-GRADE CONTROL JOINTS TO BE CLEANED AND CAULKED PRIOR TO PLACEMENT OF FLOOR FINISH. SEE REFLECTED CEILING PLANS FOR BULKHEAD LOCATIONS AND
- REFER TO MECHANICAL DRAWINGS FOR WALL LOUVER LOCATIONS, SIZES AND QUANTITIES. SEE A800 SERIES DRAWINGS FOR FINISH LEGEND AND PLANS. AA. SEE A200 AND A500 SERIES DRAWINGS FOR EQUIPMENT SCHEDULE
- AND PLANS. PROVIDE BLOCKING IN STUD WALLS AND/OR GROUTED MASONRY CORES AS REQUIRED TO SUPPORT EQUIPMENT. BB. WHERE DISIMILAR FLOOR MATERIALS MEET, THEY SHALL DO SO UNDER THE CENTERLINE OF THE DOOR UNLESS NOTED OTHERWISE. CC. APPLY SEALANT AT ALL JUNCTURES BETWEEN DIFFERENT
- MATERIALS (E.G. MASONRY TO GYPSUM WALL BOARD) UTILIZING THE APPROPRIATE TYPE PER SPECIFICATIONS. COLOR TO BE SELECTED BY ARCHITECT. DD. APPLY SEALANT AT ALL COUNTERTOPS AND BLACKSPLASHES AT
- JUNCTURE WITH WALL. EE. ALL DOORS MUST BE INSTALLED WITH AT LEAST THE MINIMUM MANEUVERING CLEARANCE AT THE DOOR APPROACH PER THE MOST CURRENT AMERICANS WITH DISABILITIES ACT. FF. BASE FLOOR ELEVATION INDICATED FOR THIS PROJECT IS 0'-0"

#### GENERAL ROOF NOTES

. CONTRACTOR SHALL REMOVE CONSTRUCTION DEBRIS FROM THE BUILDING AND

REFER TO SITE PLAN FOR CORRELATION TO USGS DATUM.


PROVIDE TREATED WOOD BLOCKING EQUAL IN THICKNESS TO INSULATION SYSTEM AT ROOF PERIMETER AND AROUND ALL ROOF PENETRATIONS. ANCHOR PER SECTION I-49 OF THE FM GLOBAL LOSS PREVENTION GUIDE.

EXTEND ALL PLUMBING VENTS TO PROVIDE A MIN. OF 12" OF HEIGHT FROM TOP

- OF INSULATION. ALL FITTINGS TO BE AIR AND WATER TIGHT. SEE PLUMBING PLANS FOR LOCATIONS. PROVIDE SADDLES/CRICKETS AROUND ALL NEW ROOF TOP EQUIPMENT. SEE MECHANICAL, ELECTRICAL AND PLUMBING DRAWINGS FOR LOCATIONS OF ALL
- ROOF PENETRATIONS. E. PERIMETER EDGE METAL TO COMPLY WITH ANSI/SPRI ES-1 FM GLOBAL 1-49.
- SEE MECHANICAL, ELECTRICAL AND PLUMBING (MEP) SHEETS FOR ROOF TOP INSPECT ALL WOOD BLOCKING SCHEDULED TO REMAIN. NOTIFY ARCHITECT OF ANY DETERIORATED BLOCKING NEEDING REPLACEMENT. CONTRACTOR TO
- REPLACE AND DAMAGED BLOCKING ON A TIME AND MATERIAL BASIS, SEE . ALL ROOF DETAIL DRAWINGS CONTAINED IN THIS SET ARE DIAGRAMMATIC. ADJUST ROOF DETAILS BASED ON SPECIFIC ROOFING SYSTEM SELECTED ACCORDING TO MANUFACTURER'S WRITTEN SPECIFICATIONS AND APPROVED DETAIL DRAWINGS. ALL ASSEMBLY COMPLICATIONS SHOULD BE BROUGHT TO
- THE ATTENTION OF THE ARCHITECT. THE ROOF CONTRACTOR SHALL PROTECT ALL ROOF DRAINS, GUTTERS AND DOWNSPOUTS FROM DEBRIS CREATED DURING CONSTRUCTION. THE ROOF CONTRACTOR SHALL CLEAR ALL DRAINS, GUTTERS AND DOWNSPOUTS PRIOR TO COMPLETION OF WORK AND TO ENSURE THAT THEY ARE FREE OF DEBRIS AND FUNCTIONING PROPERLY.
- 0. MECHANICAL, ELECTRICAL AND PLUMBING INFORMATION SHOWN ON THIS PLAN IS GENERAL IN NATURE. REFER TO P, M AND E DRAWINGS FOR FURTHER INFORMATION AND COORDINATE ALL REQUIRED ROOF OPENINGS OR ROOF MOUNTED EQUIPMENT.

#### **WALL TYPE NOTES**

1. CMU WALLS WITH A " # " SYMBOL FOLLOWING THE WALL TYPE SHALL STOP 8" ABOVE LOW CEILING HEIGHT AS INDICATED IN REFLECTED CEILING PLANS. 2. WALL TYPES ARE ASSUMED TO BE CONTINUOUS WITHIN THE SAME PLANE OR SURFACE UNTIL ANOTHER TAG IS SHOWN.

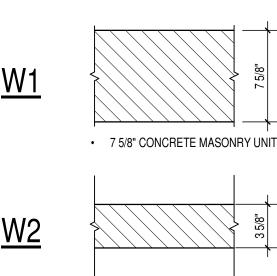

3 5/8" CONCRETE MASONRY UNIT



NG

of structural, mechanical and electrical systems.

The drawings do not necessarily indicate or describe all equirements of the Contract.

On the basis of the general scope indicated or describ the trade contractors shall furnish all items required for the proper execution and completion of the work. REVISIONS:

SCOPE DRAWINGS:

ADDENDUM #1 01/17/25

ISSUE DATE | DRAWN BY | CHECKED BY

DRAWING TITLE: FLOOR PLAN


01/10/25 MEW



DRAWING NUMBER PROJECT NUMBER

2024079



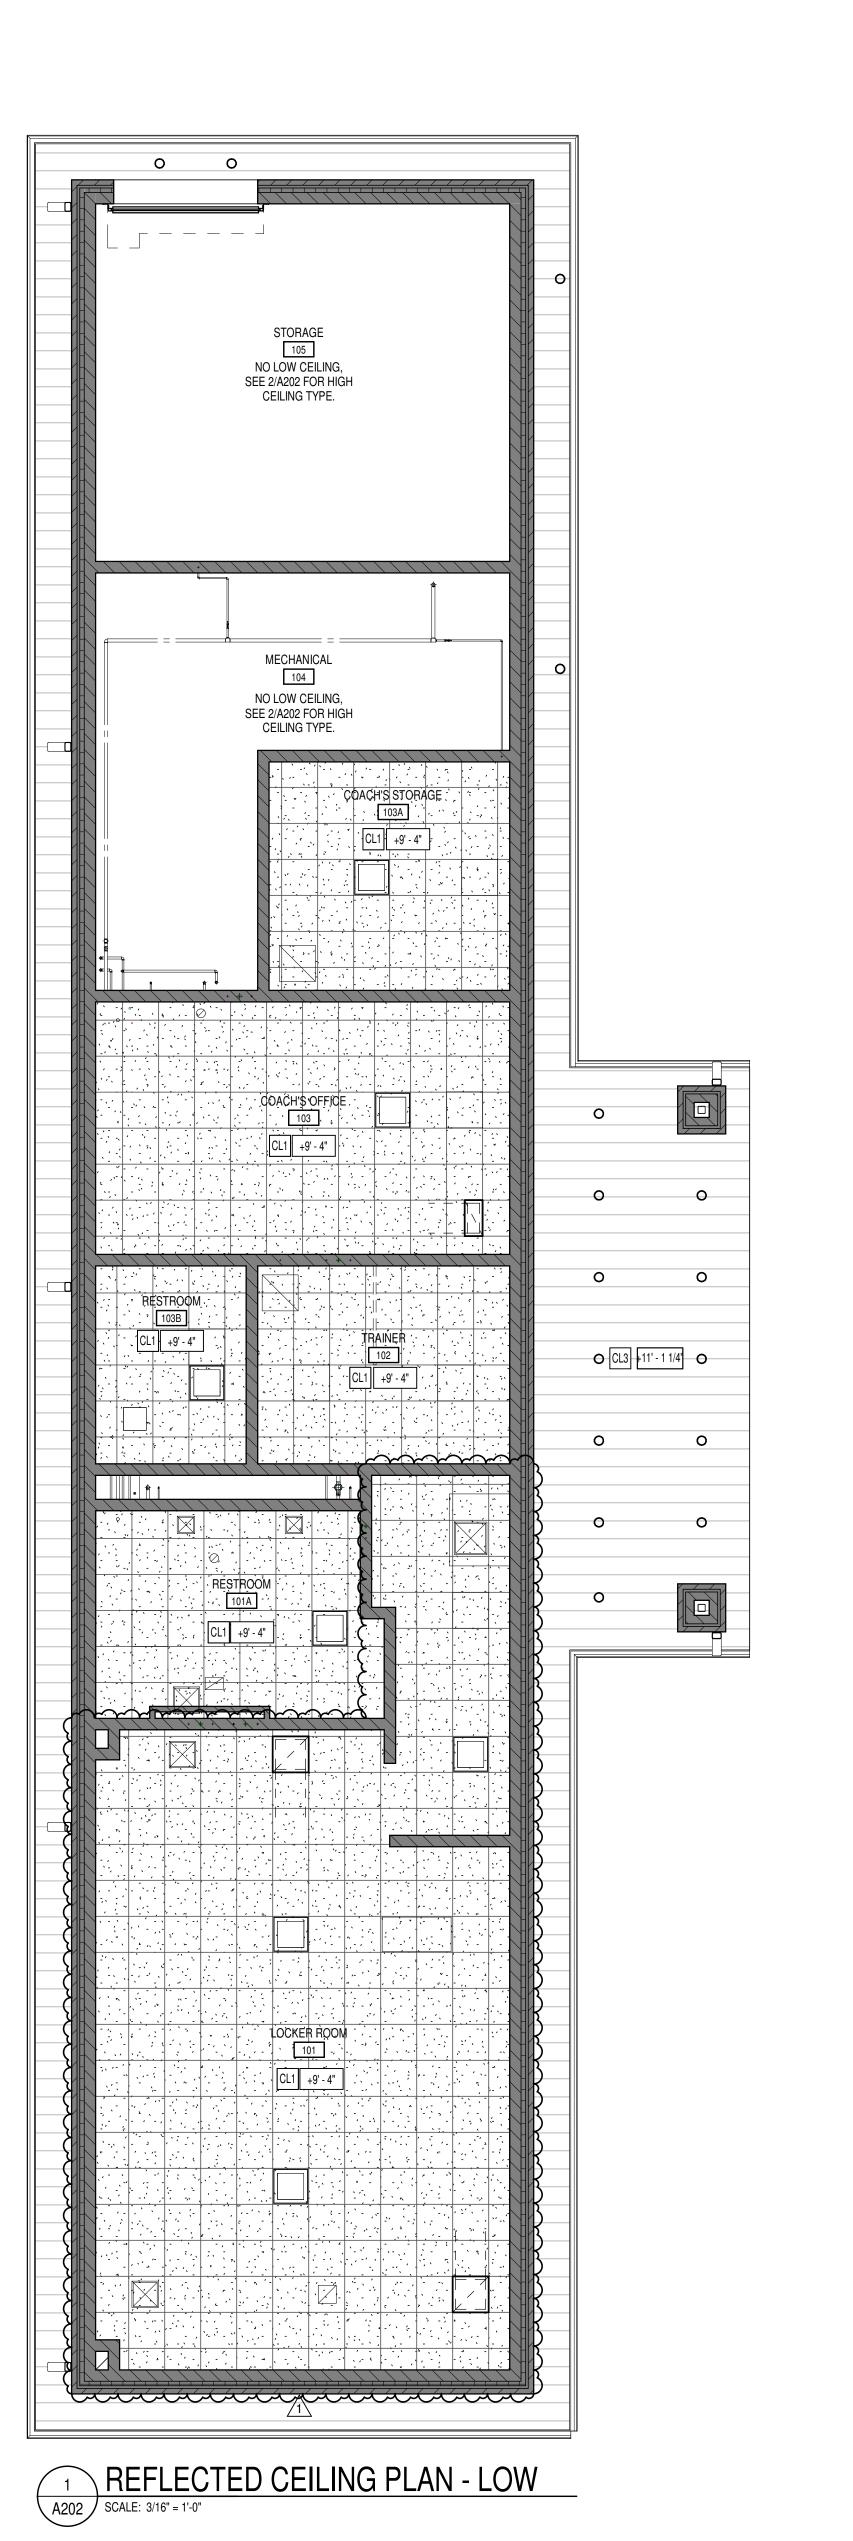

#### GENERAL NOTES

- A. COORDINATE THE WORK OF EACH TRADE WITH THE WORK OF OTHER TRADES. B. ALL WORK IS TO BE COMPLETED IN STRICT ACCORDANCE WITH ALL APPLICABLE CODES, ORDINANCES, RULES, REGULATIONS AND STANDARDS INCLUDING, BUT NOT LIMITED TO THOSE LISTED ON THE COVER SHEET. ALL APPLICABLE RULES & REGULATIONS ARE TO BE
- THE MOST CURRENT ADOPTED EDITIONS. ALL WORK SHALL BE IN ACCORDANCE WITH THE BEST QUALITY STANDARDS OF THE TRADE, AND SHALL CONFORM WITH THE LATEST EDITION OF ALL FEDERAL, STATE, AND LOCAL CODES AND STANDARDS. THE SAME ARE MADE A PART OF THESE CONTRACT
- DOCUMENTS, AS IF REPEATED HEREIN. CONTRACT DOCUMENTS CONSIST OF BOTH THE PROJECT MANUAL AND DRAWINGS, AND BOTH ARE INTENDED TO BE COMPLEMENTARY. ANYTHING APPEARING ON EITHER MUST BE EXECUTED THE SAME AS IF SHOWN ON BOTH.
- CONSTRUCTION DOCUMENTS SHALL BE FOLLOWED AS CLOSELY AS POSSIBLE, HOWEVER, SYSTEMS HAVE BEEN SHOWN DIAGRAMMATICALLY AND IN SOME CASES, ENLARGED FOR CLARITY. PROVIDE ADDITIONAL ITEMS AS REQUIRED TO PROVIDE A COMPLETE AND COORDINATED SYSTEM. CONTRACTOR SHALL PROVIDE ANY AND ALL TEMPORARY UTILITY
- SERVICE REQUIRED TO CONSTRUCT THE WORK. CONTRACTOR MAY EXTEND SERVICES FROM EXISTING LOCATIONS TO WHERE THEY ARE REQUIRED. REMOVE TEMPORARY UTILITIES AND RELATED EXTENSIONS AS SOON AS PRACTICABLE. RESTORE ALL AFFECTED AREAS TO ORIGINAL CONDITION. STORE VOLATILE OR FLAMMABLE LIQUIDS IN UL LISTED FIRE
- CONTRACTOR SHALL BE SOLELY RESPONSIBLE FOR THE SECURITY OF ALL STORED MATERIALS AND EQUIPMENT INSIDE OR OUTSIDE
- THE BUILDING. CONTRACTOR SHALL FURNISH NECESSARY TEMPORARY PROTECTION FROM WEATHER TO PROTECT INTERIOR OF BUILDING FROM ELEMENTS OF WEATHER AT ALL TIMES. CONTRACTOR RESPONSIBLE FOR TRAFFIC PROTECTION DURING CONSTRUCTION. AREAS OF WORK SUBJECTED TO TRAFFIC BY VARIOUS TRADES SHALL BE PROTECTED BY TEMPORARY WALK
- FIELD VERIFY EXISTING CONDITIONS AND DIMENSIONS PRIOR TO THE COMMENCEMENT OF WORK. DISCREPANCIES BETWEEN THE DOCUMENTS AND THE ACTUAL CONDITIONS SHALL BE BROUGHT TO THE ATTENTION OF THE ARCHITECT PRIOR TO THE COMMENCEMENT
- ALL DIMENSIONS ARE FROM CENTERLINE OF STRUCTURE, FINISH FACE OF WALL, FACE OF MASONRY, OR FACE OF EXISTING.

M. ANY DIMENSIONS NOT SHOWN OR DEEMED QUESTIONABLE ARE TO

- BE VERIFIED BY ARCHITECT. DO NOT SCALE DRAWINGS. REFER TO WALL TYPE SCHEDULE AND NOTES (A201) TO DETERMINE WHICH WALLS DO NOT EXTEND TO STRUCTURE ABOVE.
- REFER TO PLUMBING PLANS FOR LOCATION OF FLOOR DRAINS. WHERE ACCESS PANELS ARE SHOWN IN TOILET ROOM CHASES, FINAL LOCATION SHALL BE COORDINATED WITH OTHER TRADES PRIOR TO INSTALLATION.
- ALL CONCRETE MASONRY UNITS (CMU) SHALL BE LAID RUNNING BOND U.N.O. CMU WALLS THAT DO NOT LAY OUT IN FULL OR HALF LENGTHS SHOULD BE BALANCED SO AS NOT TO HAVE ANY PIECES
- LESS THAN 4" IN SIZE EXPOSED TO VIEW. THERE SHALL BE PERIMETER INSULATION CONTINUOUS AROUND THE ENTIRE PERIMETER OF THE BUILDING EXTENDING 2'-0" MINIMUM
- (R-15 MIN.) HORIZONTAL. PROVIDE MISCELLANEOUS SUPPORT FOR ALL CEILING SUSPENDED DOOR AND FRAME NUMBERS CORRESPOND TO ROOM NUMBERS.
- WHERE MORE THAN ONE DOOR OCCURS IN A ROOM, A SUFFIX HAS BEEN ADDED (E.G. A100-1). SEE A500 SERIES DRAWINGS FOR DOOR SCHEDULE AND DETAILS. ALL DOOR FRAMES SHALL BE LOCATED 4" OFF FINISH WALLS OR 4"
- OFF MASONRY WALLS UNLESS NOTED OTHERWISE. V. ALL GLASS AT INTERIOR DOOR FRAMES, DOOR LITES AND WINDOW FRAMES IS TO BE 1/4" CLEAR TEMPERED GLASS UNLESS NOTED
- W. ALL SLAB-ON-GRADE CONTROL JOINTS TO BE CLEANED AND CAULKED PRIOR TO PLACEMENT OF FLOOR FINISH.
- SEE REFLECTED CEILING PLANS FOR BULKHEAD LOCATIONS AND
- REFER TO MECHANICAL DRAWINGS FOR WALL LOUVER LOCATIONS, SIZES AND QUANTITIES.
- SEE A800 SERIES DRAWINGS FOR FINISH LEGEND AND PLANS. AA. SEE A200 AND A500 SERIES DRAWINGS FOR EQUIPMENT SCHEDULE AND PLANS, PROVIDE BLOCKING IN STUD WALLS AND/OR GROUTED MASONRY CORES AS REQUIRED TO SUPPORT EQUIPMENT.
- BB. WHERE DISIMILAR FLOOR MATERIALS MEET. THEY SHALL DO SO UNDER THE CENTERLINE OF THE DOOR UNLESS NOTED OTHERWISE. CC. APPLY SEALANT AT ALL JUNCTURES BETWEEN DIFFERENT MATERIALS (E.G. MASONRY TO GYPSUM WALL BOARD) UTILIZING THE APPROPRIATE TYPE PER SPECIFICATIONS. COLOR TO BE SELECTED
- BY ARCHITECT. DD. APPLY SEALANT AT ALL COUNTERTOPS AND BLACKSPLASHES AT JUNCTURE WITH WALL.
- EE. ALL DOORS MUST BE INSTALLED WITH AT LEAST THE MINIMUM MANEUVERING CLEARANCE AT THE DOOR APPROACH PER THE
- MOST CURRENT AMERICANS WITH DISABILITIES ACT. FF. BASE FLOOR ELEVATION INDICATED FOR THIS PROJECT IS 0'-0" REFER TO SITE PLAN FOR CORRELATION TO USGS DATUM.

#### GENERAL REFLECTED CEILING PLAN NOTES

- A. SEE THE ELECTRICAL DRAWINGS FOR SIZES, TYPES, AND QUANTITIES OF LIGHT FIXTURES, SPEAKERS, SMOKE DETECTORS, AND OTHER CEILING MOUNTED ELECTRICAL DEVICES.
- SEE THE MECHANICAL DRAWINGS FOR SIZES, TYPES, AND QUANTITIES OF DIFFUSERS, GRILLES, AND OTHER MECHANICAL
- CEILING MOUNTED DEVICES. PROVIDE, FIELD LOCATE AND INSTALL 16"x16" FLUSH ACCESS PANELS AT ALL MECHANICAL AND PLUMBING PIPING VALVE LOCATIONS ABOVE SUSPENDED GYPSUM BOARD CEILINGS. SEE THE
- MECHANICAL, AND PLUMBING DRAWINGS FOR LOCATIONS. SEE THE STRUCTURAL DRAWINGS FOR MASONRY WALLS USED FOR SHEAR WALLS THAT ARE REQUIRED TO EXTEND TO DECK/STRUCTURE ABOVE. PROVIDE BRACING FOR ALL MASONRY WALLS NOT EXTENDING TO THE DECK/STRUCTURE AS DETAILED ON STRUCTURAL DRAWINGS.
- THE SUSPENDED ACOUSTICAL TILE CEILING GRID AS SHOWN ON THESE DRAWINGS IS REPRESENTATIONAL. THE CEILING GRID IS TO BE BROKEN AS REQUIRED AT LIGHT FIXTURES, PROJECTION SCREENS, ETC.
- SEE MECHANICAL, PLUMBING AND ELECTRICAL DOCUMENTS FOR ADDITIONAL CEILING WORK REQUIRED BY NEW MEP WORK.

#### REFLECTED CEILING LEGEND

FLUORESCENT LIGHT FIXTURES, RECESSED OR SURFACED MOUNTED, SEE ELECTRICAL DRAWINGS DOWNLIGHT/HIGH BAY LIGHT FIXTURE; SEE ELECTRICAL

CEILING MOUNTED PROJECTOR, SEE TECHNOLOGY DRAWINGS RETURN/EXHAUST GRILL; SEE MECHANICAL DRAWINGS

> SUPPLY AIR GRILL; SEE MECHANICAL DRAWINGS LINEAR SLOT SUPPLY AIR GRILL; SEE MECHANICAL DRAWINGS SUSPENDED ACOUSTICAL LAY-IN CEILING MFG: ARMSTRONG MODEL #1935

CL1 DESCRIPTION: SQUARE EDGE COLOR: WHITE SIZE: 2' x 2' x 3/4" LOCATION: OFFICES/LOCKER ROOM/RESTROOMS GYPSUM BOARD ON BOTTOM CHORD OF TRUSSES

学者が STYLE: ULTIMA HEALTH ZONE

CL2 USE 5/8" WALLBOARD PAINT: CEILING BRIGHT WHITE UNLESS NOTED OTHERWISE. CL3 VENTED METAL PANEL SOFFIT

CEILING ELEVATION MARK ABOVE FINISHED FLOOR (AT THAT LOCATION IF MULTIPLE FLOOR LEVELS ARE PRESENT)

REFLECTED CEILING PLAN NOTES

COORDINATE FINAL LOCATION OF HATCH BETWEEN ROOF JOISTS, COORDINATE WITH STRUCTURAL FRAMING DRAWINGS.



NOBLESVILLE SCHOOLS

NG HIGH SCHIR ROOM F SVILLE NOBLE FTBALL I

SCOPE DRAWINGS: of structural, mechanical and electrical systems.

The drawings do not necessarily indicate or describe all equirements of the Contract.

On the basis of the general scope indicated or describ the trade contractors shall furnish all items required for the proper execution and completion of the work. REVISIONS:


ADDENDUM #1 01/17/25

ISSUE DATE | DRAWN BY | CHECKED BY 01/10/25 MEW

DRAWING TITLE: REFLECTED CEILING PLANS



DRAWING NUMBER

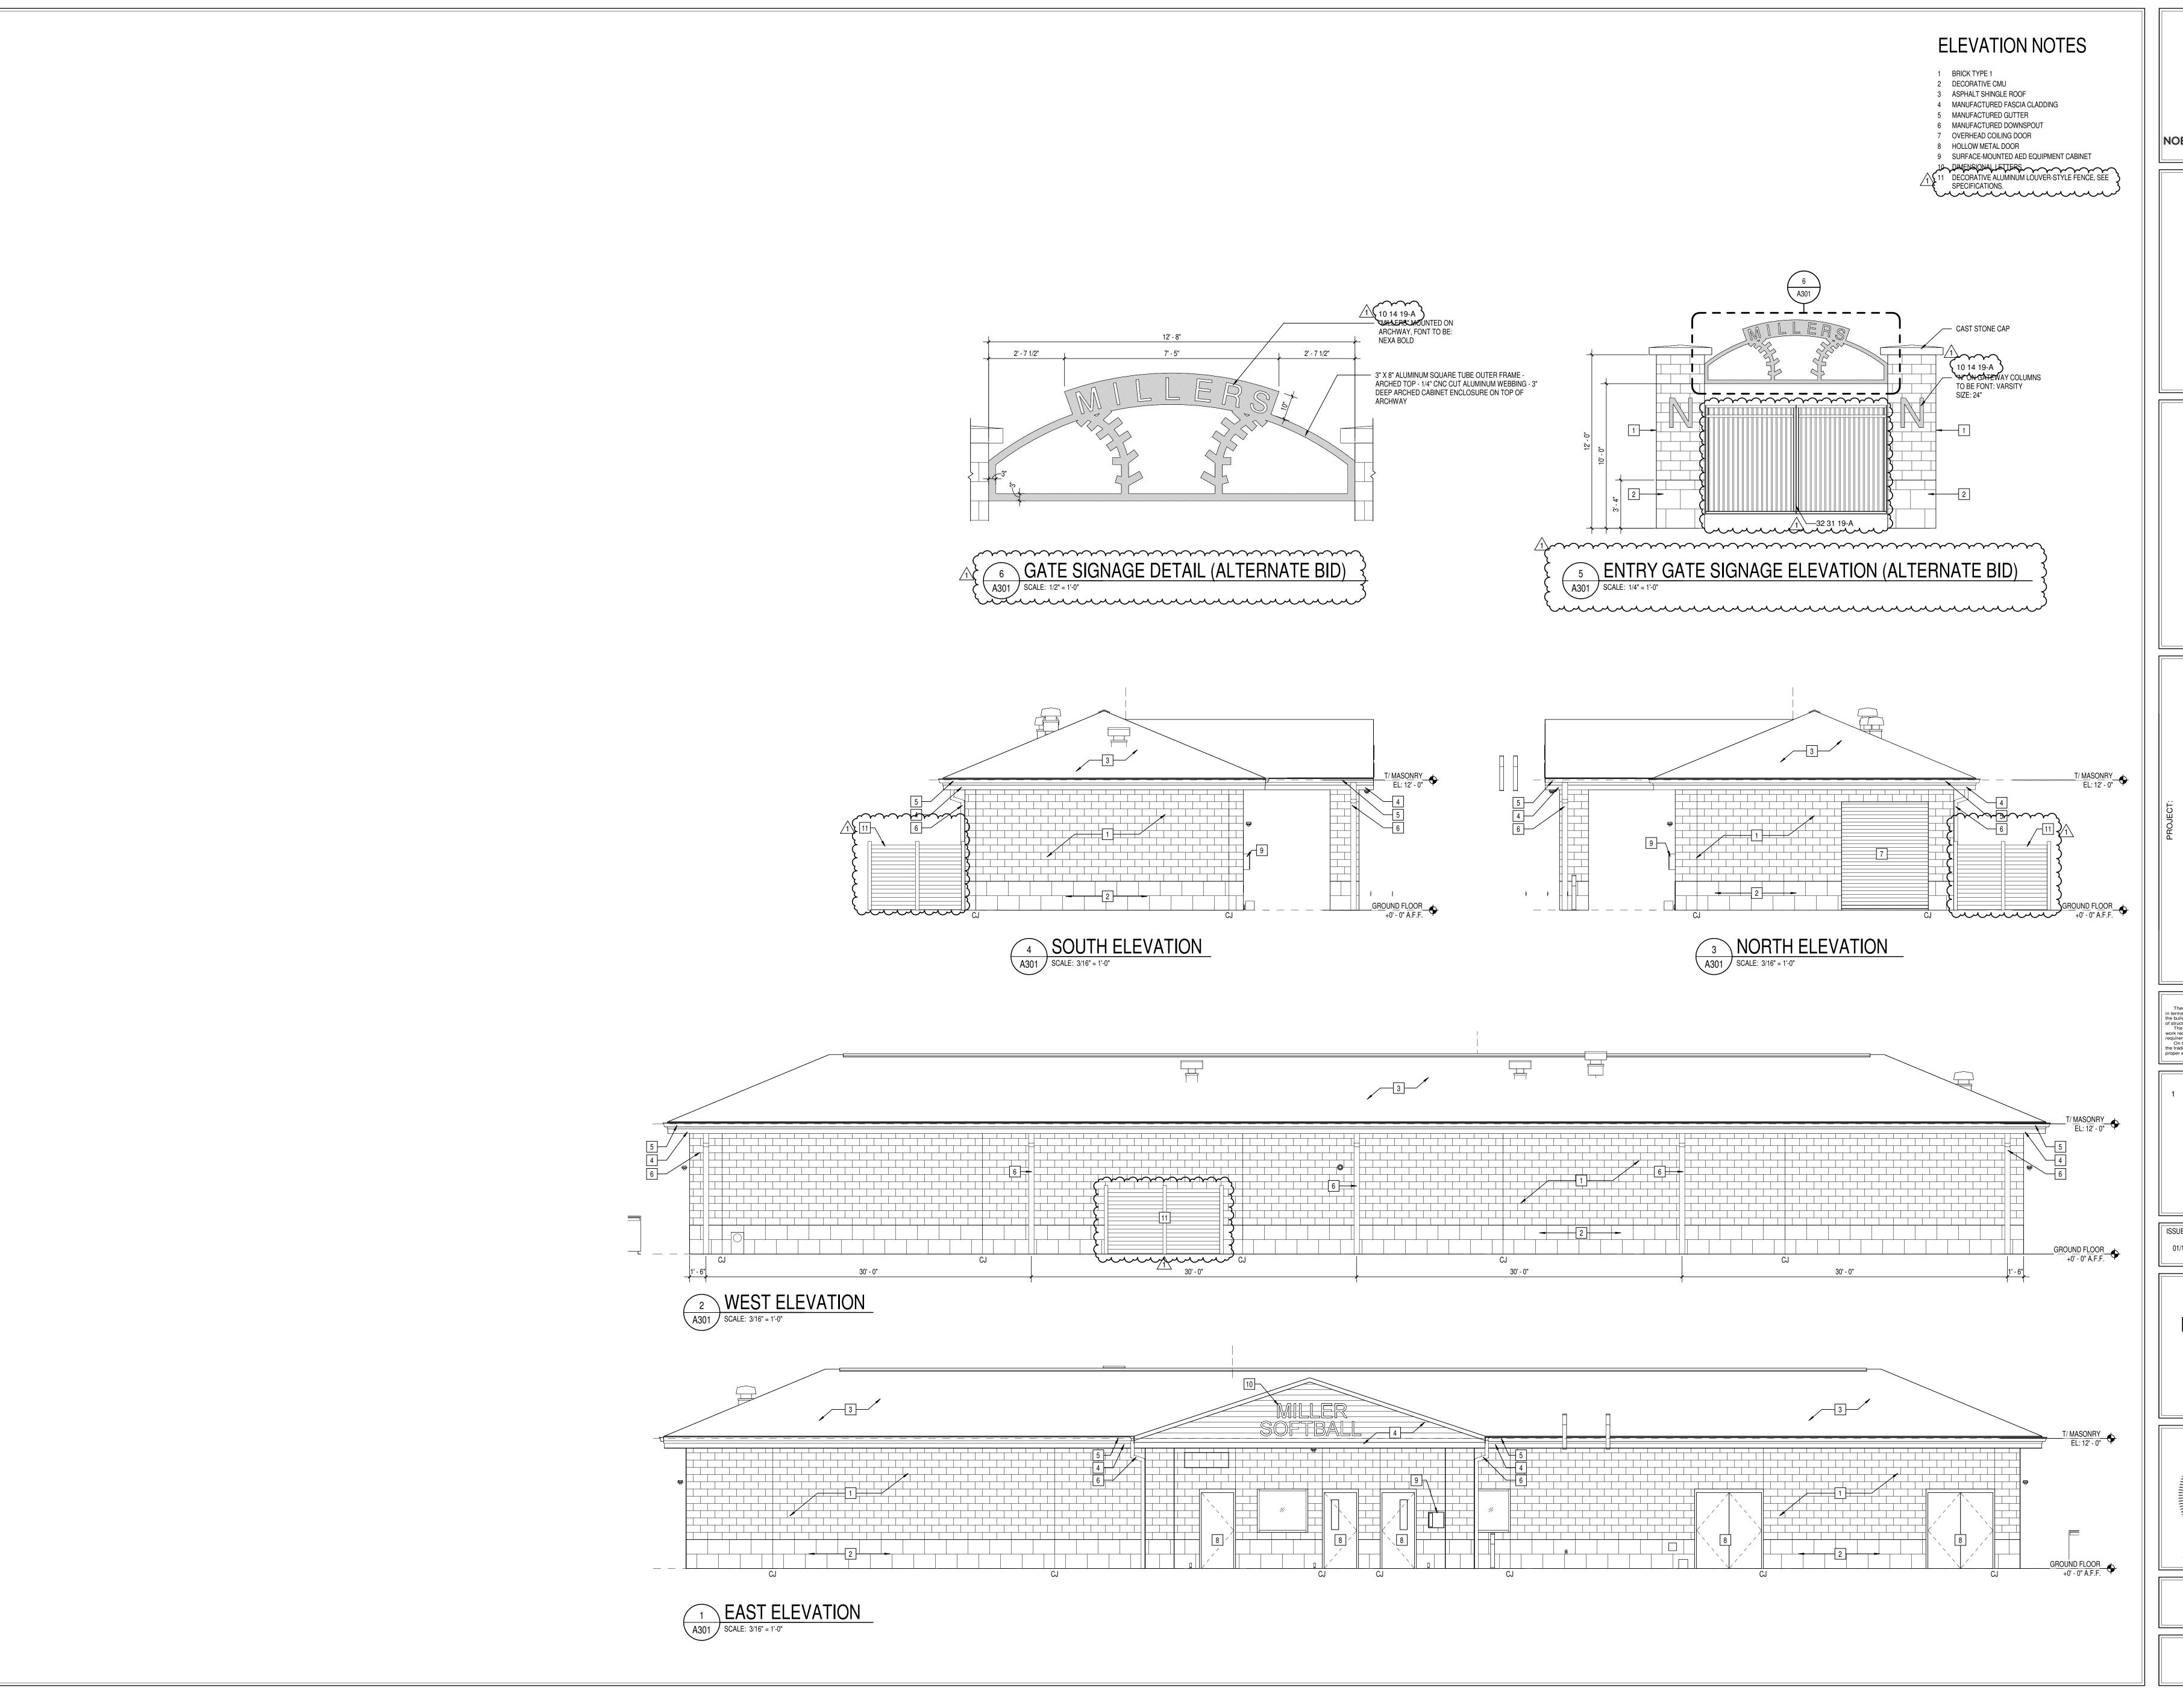



NG NOBLESVILLE HIGH SCHOOL SOFTBALL LOCKER ROOM BUILDI

SCOPE DRAWINGS:


These drawings indicate the general scope of the project in terms of architectural design concept, the dimensions of the building, the major architectural elements and the type of structural, mechanical and electrical systems.

The drawings do not necessarily indicate or describe all work required for full performance and completion of the requirements of the Contract.

On the basis of the general scope indicated or described, the trade contractors shall furnish all items required for the proper execution and completion of the work. **REVISIONS:** ADDENDUM #1 01/17/25


ISSUE DATE | DRAWN BY | CHECKED BY 01/10/25 MEW

> DRAWING TITLE: BUILDING **ELEVATIONS**

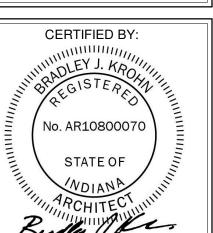

DRAWING NUMBER PROJECT NUMBER

2024079

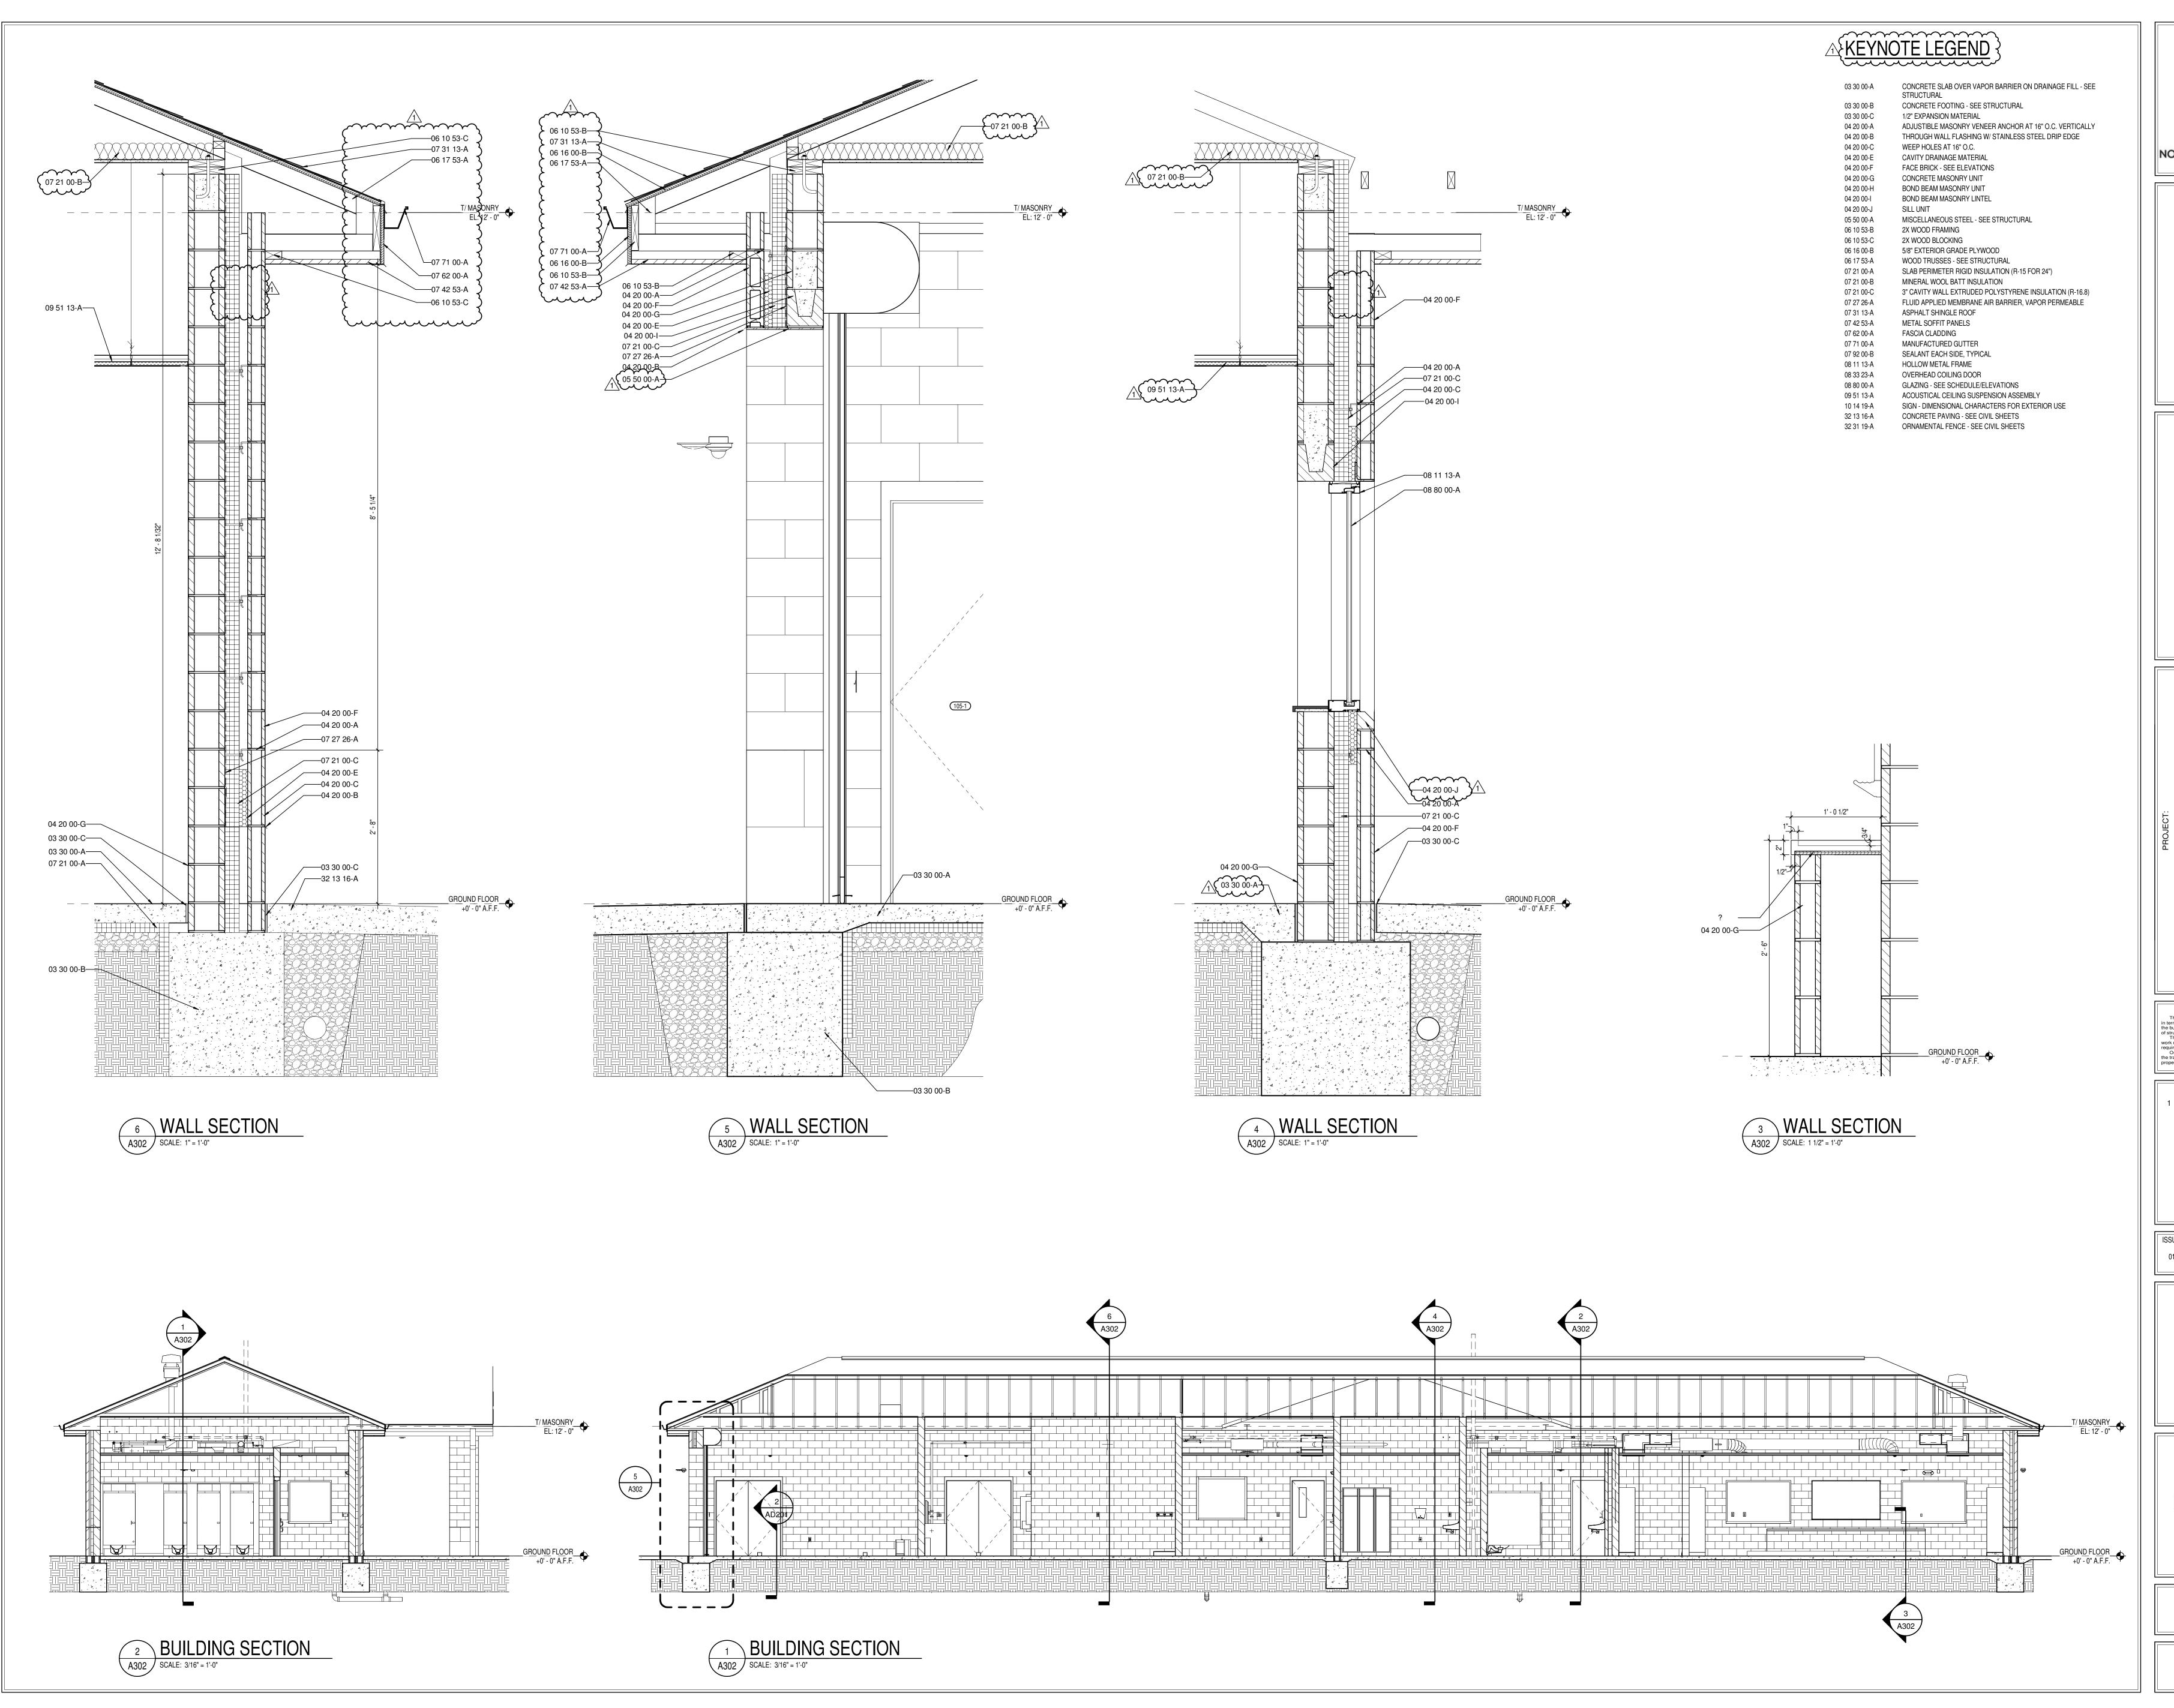



NOBLESVILLE SCHOOLS

8831 Keystone Crossing, Indianapolis, IN 46240 317.848.7800 | csoinc.net

NOBLESVILLE HIGH SCHOOL SOFTBALL LOCKER ROOM BUILDING

SCOPE DRAWINGS:

These drawings indicate the general scope of the project in terms of architectural design concept, the dimensions of the building, the major architectural elements and the type of structural, mechanical and electrical systems.

The drawings do not necessarily indicate or describe all work required for full performance and completion of the requirements of the Contract.

On the basis of the general scope indicated or described, the trade contractors shall furnish all items required for the proper execution and completion of the work.

REVISIONS:
ADDENDUM #1 01/17/25

ISSUE DATE | DRAWN BY | CHECKED BY | 01/10/25 | MEW | NW

BUILDING SECTIONS

CERTIFIED BY:

WOLEY J. KROMMING ARTOROGO STATE OF

WOLANA

ROCHITECT

WOLANA

ROCHITECT

WOLANA


ROCHITECT

WOLANA

ROCHITECT

ROCH

A302

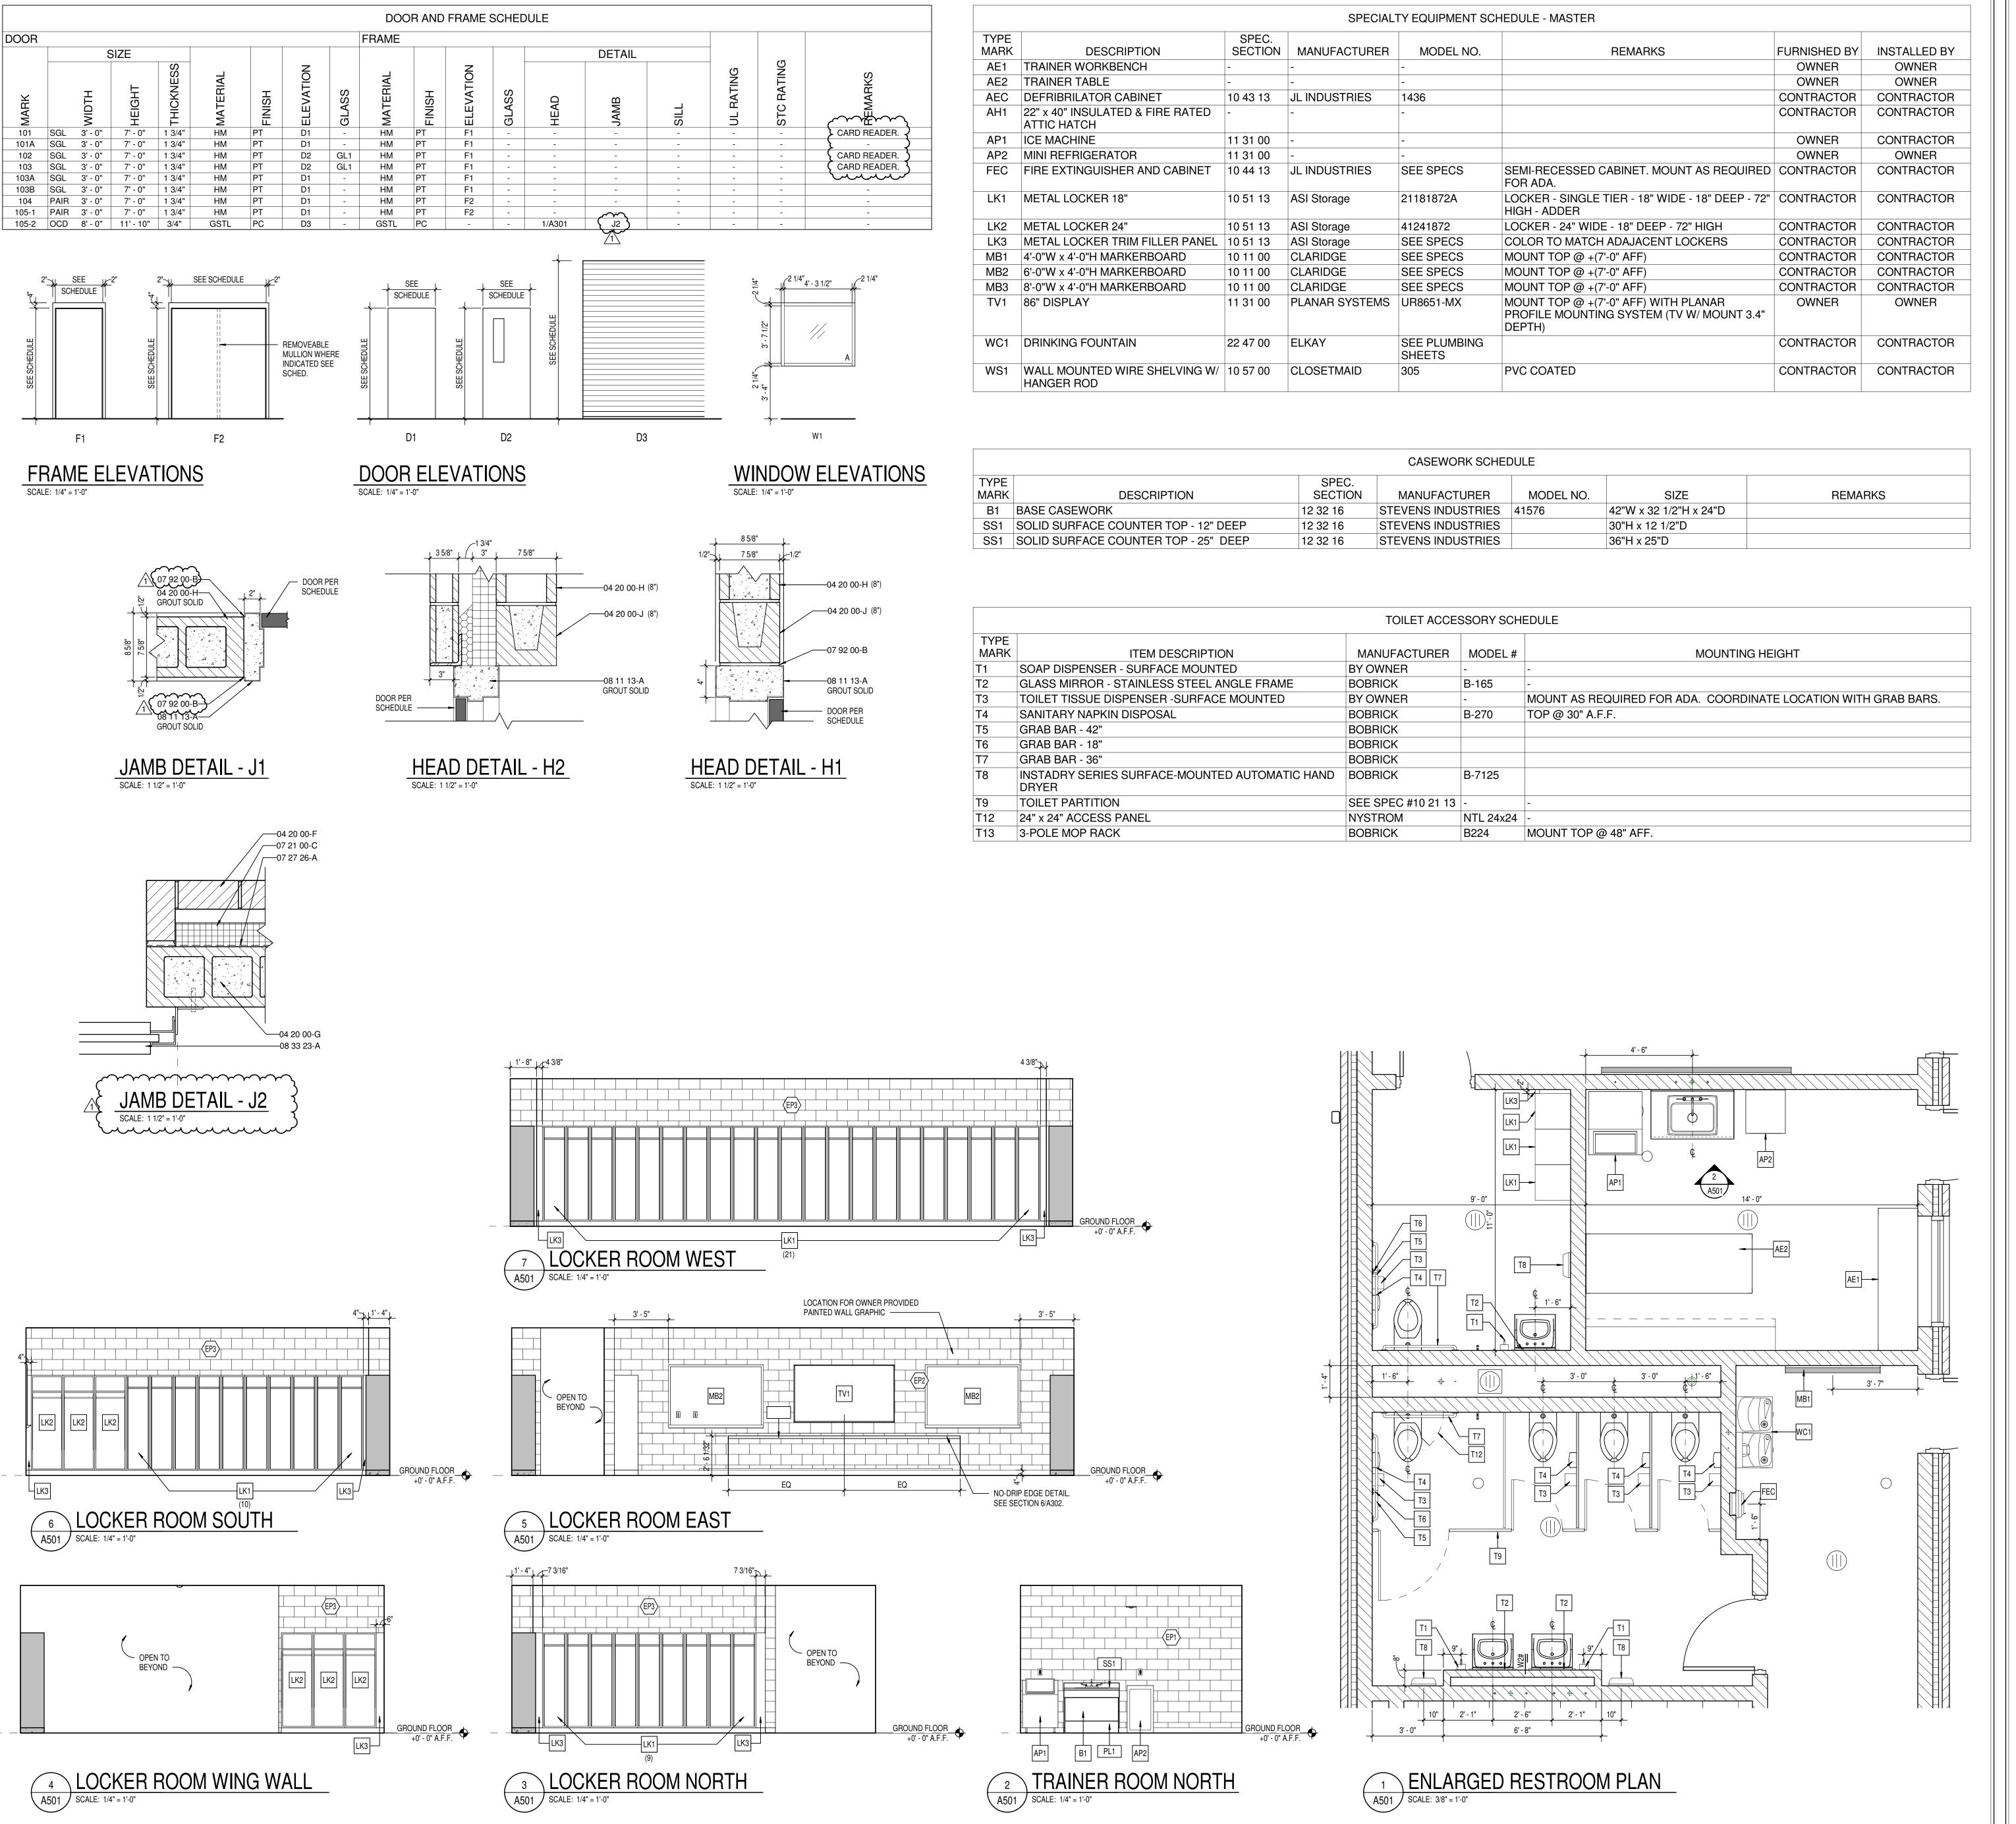

#### GLASS SCHEDULE

A. 1" THICK TEMPERED, LOW E, INSULATING GLAZING WITH 2 PANES 1/4" GLASS AND

#### **ABBREVIATIONS LEGEND**

AL = ALUMINUM AN = ANODIZED

BL = BORROWED LITE
GHM = GALVANNEALED HOLLOW METAL

GHM = GALVANNEAL
GL = GLASS
HM = HOLLOW METAL

PT = PAINT ST = STAIN SS = STAINLESS STEEL

STL = STEEL WD = WOOD 90M = 90 MINUTE ASSEMBLY RATING

STRUCTURE ABOVE.

AROUND FRAMES.

ATTENTION OF THE ARCHITECT.

#### **GENERAL DOOR NOTE**

= SEE REMARKS COLUMN FOR NOTES

- A. THESE GENERAL NOTES APPLY TO THE DOOR SCHEDULE.
   B. DOOR AND FRAME NUMBERS CORRESPOND TO RESPECTIVE ROOM NUMBER. IN ROOMS WITH MULTIPLE OPENINGS, A NUMERICAL SUFFIX HAS BEEN ADDED TO DOOR NUMBERS.
   C. VERTICAL FRAMING MEMBERS AT ALL DOOR FRAMES SHALL EXTEND TO
- D. UNDERCUT ALL DOORS AS REQUIRED BY FINAL FINISH.
  E. PROVIDE CONTINUOUS SEALANT BETWEEN HOLLOW METAL FRAME
- PERIMETERS AND SURROUNDING WALL CONSTRUCTION.

  PROVIDE CONTINUOUS SEALANT BETWEEN INTERIOR AND EXTERIOR
- WINDOW, CURTAINWALL AND STOREFRONT FRAME PERIMETERS AND SURROUNDING CONSTRUCTION UNLESS NOTED OTHERWISE.

  G. GROUT FULL HOLLOW METAL FRAMES IN MASONRY CONSTRUCTION.
- H. WHERE A FIRE RATING IS INDICATED ON THE DOOR SCHEDULE, HARDWARE
  AND DOOR ASSEMBLY COMPONENTS SHALL MEET THE REQUIREMENTS OF
  THAT LABEL.
   WHERE AN STC RATING IS INDICATED ON THE DOOR SCHEDULE, HARDWARE
- AND DOOR ASSEMBLY COMPONENTS SHALL MEET THE REQUIREMENTS OF THAT LABEL.

  INSTALL DOOR GLASS USING WET GLAZING METHOD.
- K. ALL LINTELS ABOVE EXTERIOR OPENINGS SHALL BE GALVANIZED.
  L. COORDINATE THROAT OPENINGS WITH WALL WIDTH FOR ALL WRAP
- M. ALL NEW HOLLOW METAL DOORS, FRAMES AND BORROWED LITE FRAMES
   TO BE PAINTED (EP2) AS INDICATED ON THE A800 SERIES FINISH PLANS.
   N. PROVIDE SILENCERS ON ALL DOOR FRAMES.
- O. SEE STRUCTURAL DRAWINGS FOR REQUIREMENTS FOR MASONRY AND STEEL LINTELS. PROVIDE STRUCTURAL STEEL LINTELS AT OPENINGS
- OPENINGS WHERE INDICATED ON THE STRUCTURAL STEEL DRAWINGS IN LIEU OF MASONRY LINTEL AS SHOWN IN THESE DETAILS.

  P. VERIFY ALL EXISTING CONDITIONS AND DIMENSIONS IN THE FIELD PRIOR TO FABRICATION OF DOORS AND FRAMES. BRING DISCREPANCIES TO THE

#### GENERAL CASEWORK NOTES

- A. PROVIDE FILLER PANELS AT ALL LOCATIONS WHERE CASEWORK IS FLANKED BY WALLS AS REQUIRED TO CLOSE OFF SPACE AND PROVIDE A NEAT, FINISHED INSTALLATION. PROVIDE EQUAL FILLER PANELS AT EITHER SIDE OF CASEWORK TO BALANCE APPEARANCE.

  B. PROVDIE FINISHED ENDS AT ALL CABINET SIDES PARTIALLY OR FULLY
- EXPOSED TO VIEW.

  C. SEE INTERIOR CASEWORK ELEVATIONS FOR DOOR SWING.
- D. PROVIDE COUNTER GROMMETS FOR ALL OPEN KNEE-SPACE COUNTERTOP INSTALLATIONS. LOCATION AND QUANTITY OF GROMMETS TO BE VERFIED
- WITH OWNER IN FIELD.

  E. REFER TO A200 SERIES DRAWINGS FOR FINISHES NOT NOTED ON EQUIPMENT
- PLANS AND CASEWORK ELEVATIONS.

N

NOBLESVILLE SCHOOLS

8831 Keystone Crossing, Indianapolis, IN 46240 317.848.7800 | csoinc.net

NOBLESVILLE HIGH SCHOOL SOFTBALL LOCKER ROOM BUILDING

SCOPE DRAWINGS:
These drawings indicate the general scope of the project in terms of architectural design concept, the dimensions of he building, the major architectural elements and the type of structural, mechanical and electrical systems.
The drawings do not necessarily indicate or describe all work required for full performance and completion of the equirements of the Contract.
On the basis of the general scope indicated or described, he trade contractors shall furnish all items required for the proper execution and completion of the work.


REVISIONS: ADDENDUM #1 01/17/25

ISSUE DATE | DRAWN BY | CHECKED BY


MEW

01/10/25

SCHEDULES, ENLARGED PLAN AND INTERIOR ELEVATIONS

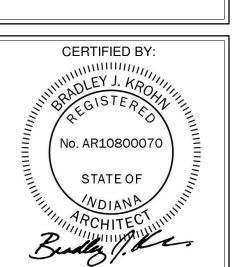

A501

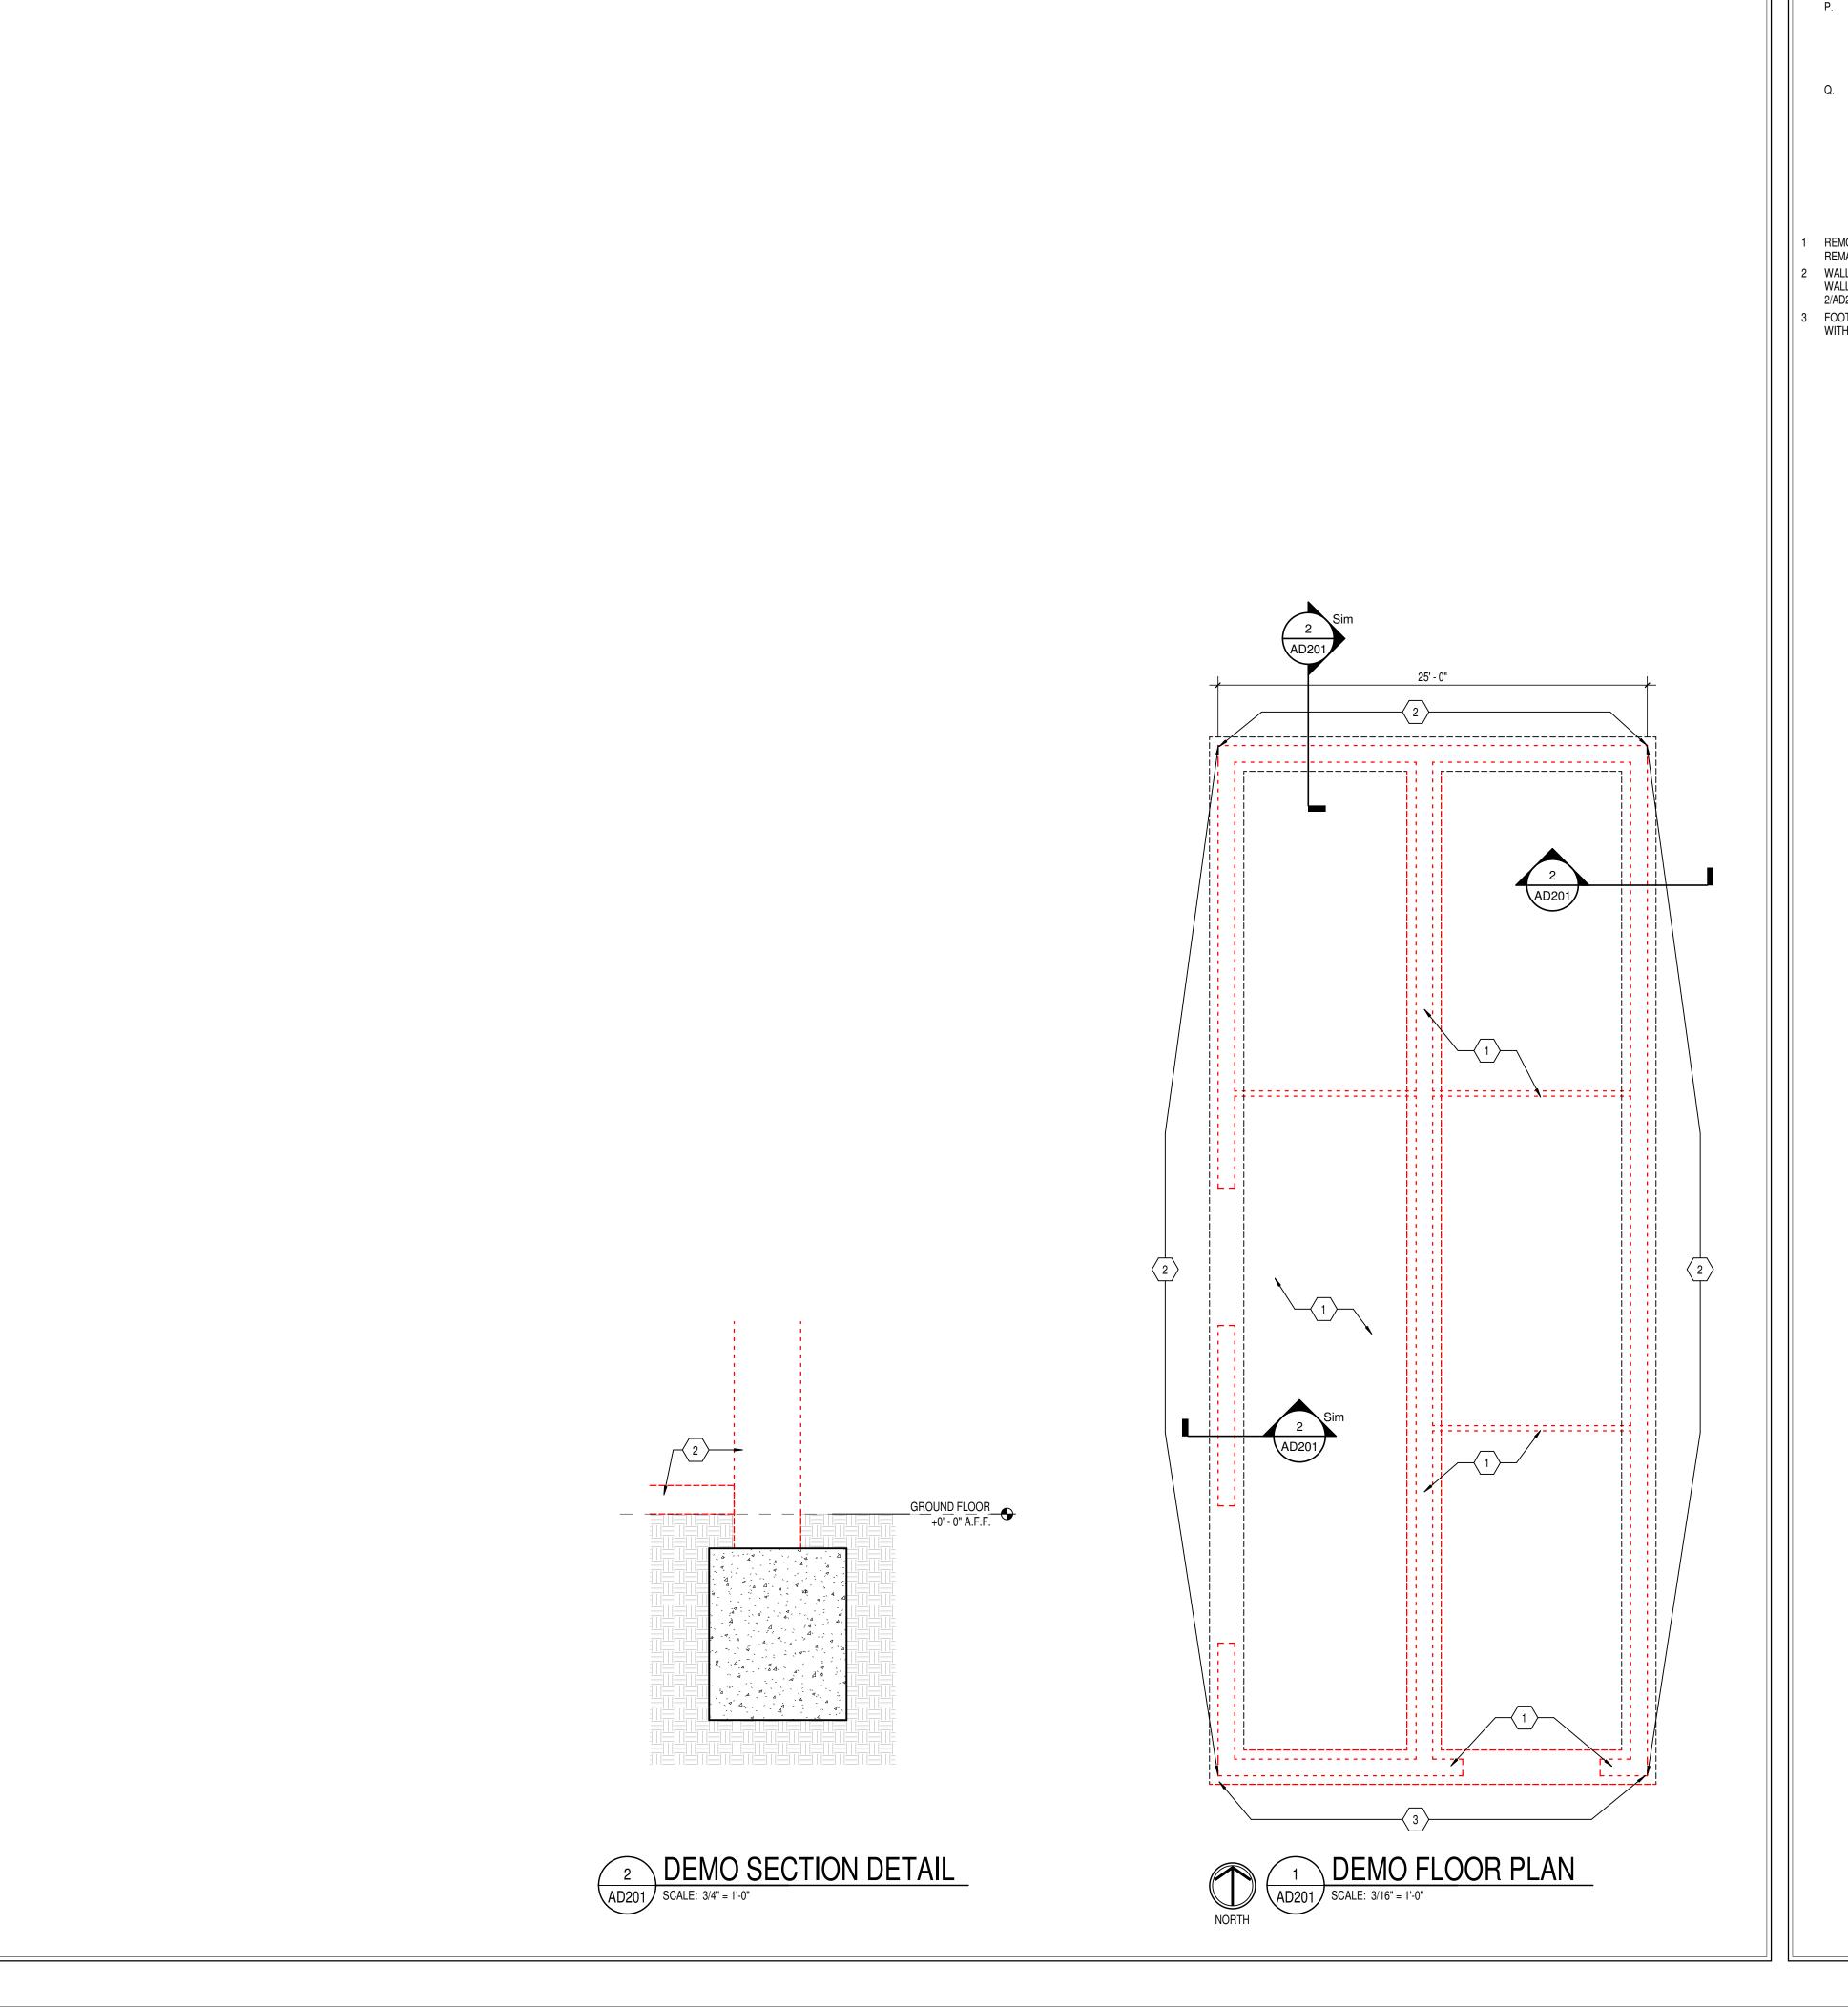

#### GENERAL DEMOLITION NOTES

- A. HEAVY DASHED LINES INDICATE STRUCTURE, WALLS AND ITEMS TO BE DEMOLISHED UNLESS NOTED OTHERWISE.
- B. SOLID LINES INDICATE STRUCTURE, WALLS, & ITEMS TO REMAIN, UNLESS NOTED OTHERWISE.
  C. PROTECT ALL FINISHES, EQUIPMENT & OTHER ITEMS TO REMAIN.
- WHERE DAMAGE OCCURS, PATCH AND REPAIR OR OTHERWISE
  RESTORE TO ITS ORIGINAL CONDITION OR REPLACE.
- RESTORE TO ITS ORIGINAL CONDITION OR REPLACE.

  D. CONTRACTOR SHALL FIELD VERIFY ALL EXISTING CONSTRUCTION AND RELATED CONDITIONS PRIOR TO STARTUP OF DEMOLITION OR
- AND RELATED CONDITIONS PRIOR TO STARTUP OF DEMOLITION O NEW CONSTRUCTION.

  E. COORDINATE EXTENTS AND EXACT DIMENSIONS WITH EXTENTS
- AND EXACT DIMENSIONS OF NEW WORK.

  F. ANY AND ALL DISCREPANCIES SHALL BE BROUGHT TO THE IMMEDIATE ATTENTION OF THE ARCHITECT AND OWNER.
- IMMEDIATE ATTENTION OF THE ARCHITECT AND OWNER.

  G. REMOVE ALL MISCELLANEOUS EQUIPMENT ATTACHED TO WALLS,
  ELOOPS AND CELLINGS TO BE DEMOLISHED. COORDINATE WITH
- FLOORS AND CEILINGS TO BE DEMOLISHED. COORDINATE WITH
  THE OWNER FOR ITEMS TO BE SALVAGED OR RE-INSTALLED.
  H. REMOVE ANY ITEMS NOT SPECIFICALLY IDENTIFIED TO BE

REMOVED WHICH MUST OBVIOUSLY BE DEMOLISHED TO

ACCOMMODATE NEW WORK. VERIFY WITH ARCHITECT.

I. ALL OPENINGS, VOIDS, OR DAMAGED SURFACES LEFT BY THE REMOVAL OF EXISTING CONSTRUCTION, EQUIPMENT, PIPING, DUCTS, WINDOWS, ETC., SHALL BE PATCHED & REPAIRED TO MATCH SURROUNDING WORK. PREPARE TO RECEIVE NEW

FINISHES AS REQUIRED.

- REMOVE ALL MASTIC, ADHESIVES, FASTENERS AND OTHER MATERIALS WHERE FINISHES (SUCH AS FLOORING, BASE) AND EQUIPMENT (SUCH AS CASEWORK, TACKBOARDS, MARKERBOARDS, MECHANICAL ITEMS, ETC.) HAVE BEEN REMOVED AT EXISTING SURFACES TO REMAIN.
- K. CONSTRUCT DUST AND SOUND CONTROL BARRIERS PRIOR TO THE START OF WORK.
   L. SEE SPECIFICATIONS FOR ASSIGNMENT OF RESPONSIBILITIES PERTAINING TO PATCHING AND REPAIR WORK REQUIRED OF EACH
- M. DEMOLITION WORK TO BE COMPLETED BY MECHANICAL/PLUMBING, ELECTRICAL TRADES IS SHOWN ON OTHER SHEETS IN THIS SET OF CONTRACT DOCUMENTS. THIS CONTRACTOR SHALL REVIEW THE DEMOLITION WORK OF OTHER TRADES TO DETERMINE WHERE
- SUCH WORK COULD AFFECT HIS WORK AND SHALL COORDINATE
  HIS WORK WITH THE WORK OF ALL OTHER TRADES.

  N. AT NEW OPENINGS IN EXISTING BRICK MASONRY WALLS, TOOTH IN
  BRICK TO MATCH EXISTING.
- O. AT NEW OPENINGS IN EXISTING CONCRETE MASONRY WALLS,
  TOOTH IN NEW CMU TO MATCH EXISTING.
- P. WHERE EXISTING SURFACE MOUNTED VISUAL DISPLAY BOARDS (MARKER, CHALK, TACK BOARDS) ARE BEING REMOVED FROM WALLS, WALL SURFACE BEHIND BOARD IS TO BE PREPARED TO MATCH TEXTURE OF SURROUNDING SURFACES. PROVIDE BLOCK FILLER AS REQUIRED AND PATCH MOUNTING HOLES COMPLETE. REMOVE PAINT BUILD UP AT BOARD EDGES.
- Q. CONTRACTOR IS RESPONSIBLE FOR PREP WORK REQUIRED FOR FLOOR SLAB TO RECEIVE NEW FINISHES. PREP WORK TO INCLUDE: PATCH FLOOR SLAB AT AREAS THAT WILL BE CUT TO ACCOMMODATE NEW PLUMBING LINES OR WHERE CAPPING OF EXISTING LINES BELOW THE SLAB IS REQUIRED AND FILLING IN HOLES IN SLAB WHERE EXISTING MEP HAS BEEN ABANDONED.

#### DEMOLITION NOTES

REMOVE BUILDING ELEMENTS, COMPLETE. COORDINATE EXTENTS OF EXISTING TO REMAIN WITH STRUCTURAL DRAWINGS.
 WALLS AND FLOOR SLAB TO BE REMOVED DOWN TO FOOTINGS AND FOUNDATION WALLS. EXISTING FOOTING AND FOUNDATIONS TO REMAIN. REFER TO DETAIL 2/AD201 FOR MORE INFORMATION.
 FOOTINGS AND FOUNDATION WALLS TO BE REMOVED. COMPLETE. COORDINATE

WITH STRUCTURAL DRAWINGS TO CONFIRM EXTENTS OF EXISTING TO REMAIN.

NOBLESVILLE HIGH SCHOOL FTBALL LOCKER ROOM BUILDING

NOBLESVILLE SCHOOLS

SCOPE DRAWINGS:

These drawings indicate the general scope of the project in terms of architectural design concept, the dimensions of the building, the major architectural elements and the type of structural, mechanical and electrical systems.

The drawings do not necessarily indicate or describe all work required for full performance and completion of the requirements of the Contract.


On the basis of the general scope indicated or described, the trade contractors shall furnish all items required for the proper execution and completion of the work.

REVISIONS:
ADDENDUM #1 01/17/25


ISSUE DATE | DRAWN BY | CHECKED BY

01/10/25 MEW NW

DEMO FLOOR
PLAN AND
SECTIONS

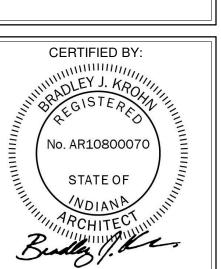

AD201

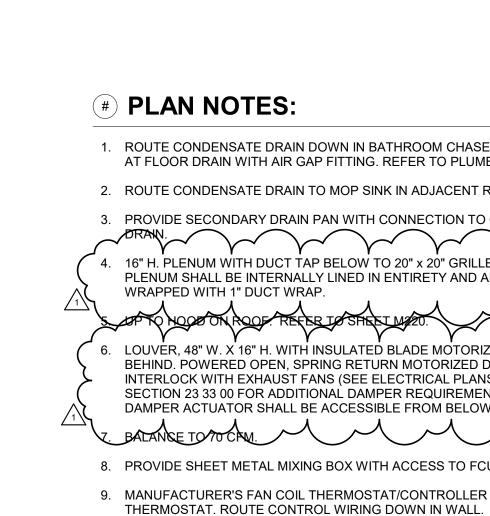

1. ROUTE CONDENSATE DRAIN DOWN IN BATHROOM CHASE AND TERMINATE AT FLOOR DRAIN WITH AIR GAP FITTING. REFER TO PLUMBING PLANS.

2. ROUTE CONDENSATE DRAIN TO MOP SINK IN ADJACENT ROOM.

3. PROVIDE SECONDARY DRAIN PAN WITH CONNECTION TO CONDENSATE 4. 16" H. PLENUM WITH DUCT TAP BELOW TO 20" x 20" GRILLE IN CEILING. PLENUM SHALL BE INTERNALLY LINED IN ENTIRETY AND ADDITIONALLY WRAPPED WITH 1" DUCT WRAP.

LOUVER, 48" W. X 16" H. WITH INSULATED BLADE MOTORIZED DAMPERS BEHIND. POWERED OPEN, SPRING RETURN MOTORIZED DAMPERS; INTERLOCK WITH EXHAUST FANS (SEE ELECTRICAL PLANS). REFER TO SECTION 23 33 00 FOR ADDITIONAL DAMPER REQUIREMENTS. MOTORIZED DAMPER ACTUATOR SHALL BE ACCESSIBLE FROM BELOW.

- 8. PROVIDE SHEET METAL MIXING BOX WITH ACCESS TO FCU FILTERS.
- 9. MANUFACTURER'S FAN COIL THERMOSTAT/CONTROLLER OR UNIT HEATER
- 10. MAINTAIN OUTDOOR UNIT 4'-0" FROM WALL OF BUILDING AND MINIMUM 30" CLEAR OF TRANSFORMER. EXTERIOR PIPING MUST BE SUPPORTED ABOVE GRADE WITH STAINLESS STEEL SUPPORTS AND HARDWARE. EXTERIOR PIPING INSULATION SHALL BE WRAPPED IN MULTILAYER WEATHERPROOF JACKET PER SECTION 20 01 80.
- 11. ROUTE PIPING OUTSIDE OF WALL TO 30" A.F.F. THEN THROUGH WALL. CONTINUE UP INSIDE OF WALL. COVER INTERIOR PIPING WITH 16 GA. GALVANIZED SHEET METAL PROTECTIVE SHROUD, NOM. 6" W x 4" D, FLOOR TO 9'-0" A.F.F.

12. 32"x8" TRANSFER OPENING IN CMU WALL ABOVE CEILING.


#### **RENOVATION LEGEND:**

WORK TO BE INSTALLED WORK TO REMAIN


DIRECTION.

#### **GENERAL NOTES - AIR DISTRIBUTION:**


- VRF SYSTEM: REFER TO SECTION 23 81 35 FOR ADDITIONAL REQUIREMENTS. PIPE SIZING, LAYOUT, AND LOCATION OF ZONE / BRANCH VALVES SHALL BE INCLUDED WITH VRF SUBMITTAL AND BE APPROVED BY THE ENGINEER.
- INSTALL VRF OUTDOOR UNIT LEVEL ON VIBRATION ISOLATIONS PADS ON 6" TALL CONCRETE EQUIPMENT PAD, PAD 4" WIDER THAN UNIT IN EACH
- ARCHITECTURAL SCREENWALL AROUND VRF OUTDOOR UNIT IS BY OTHERS REFER TO ARCHITECTURAL PLANS.
- LOUVERS: REFER TO SECTION 23 37 13. CUSTOM COLOR BY ARCHITECT.
- REFER TO ELECTRICAL PLANS FOR CONTROL OF EXHAUST FANS AND CABINET/PROPELLER UNIT HEATER WARM WEATHER LOCK-OUT CONTROLS.
- PROVIDE BACK DRAFT DAMPER AT DISCHARGE OF ALL EXHAUST FANS.
- ALL EXHAUST AND OUTDOOR AIR DUCTWORK SHALL BE INSULATED FROM DAMPER TO BUILDING ENVELOPE INSULATION. REFER TO SECTION 20 01 80 FOR ADDITIONAL INFORMATION.
- ROOF HOODS TO BE PROVIDED WITH SLOPED CURBS. HOODS AND CURBS SHALL BE PAINTED IN CUSTOM COLOR BY ARCHITECT. REFER TO SECTION 20 00 50 FOR PAINT REQUIREMENTS.
- REFER TO SECTION 23 23 00 FOR REFRIGERANT PIPING REQUIREMENTS AND SECTION 20 00 60 FOR CONDENSATE PIPING REQUIREMENTS.
- CONDENSATE DRAIN LINES SHALL BE 3/4" FROM CONNECTION AT FCU TO TERMINATION.
- REFER TO SHEET PM001 FOR ADDITIONAL INFORMATION.

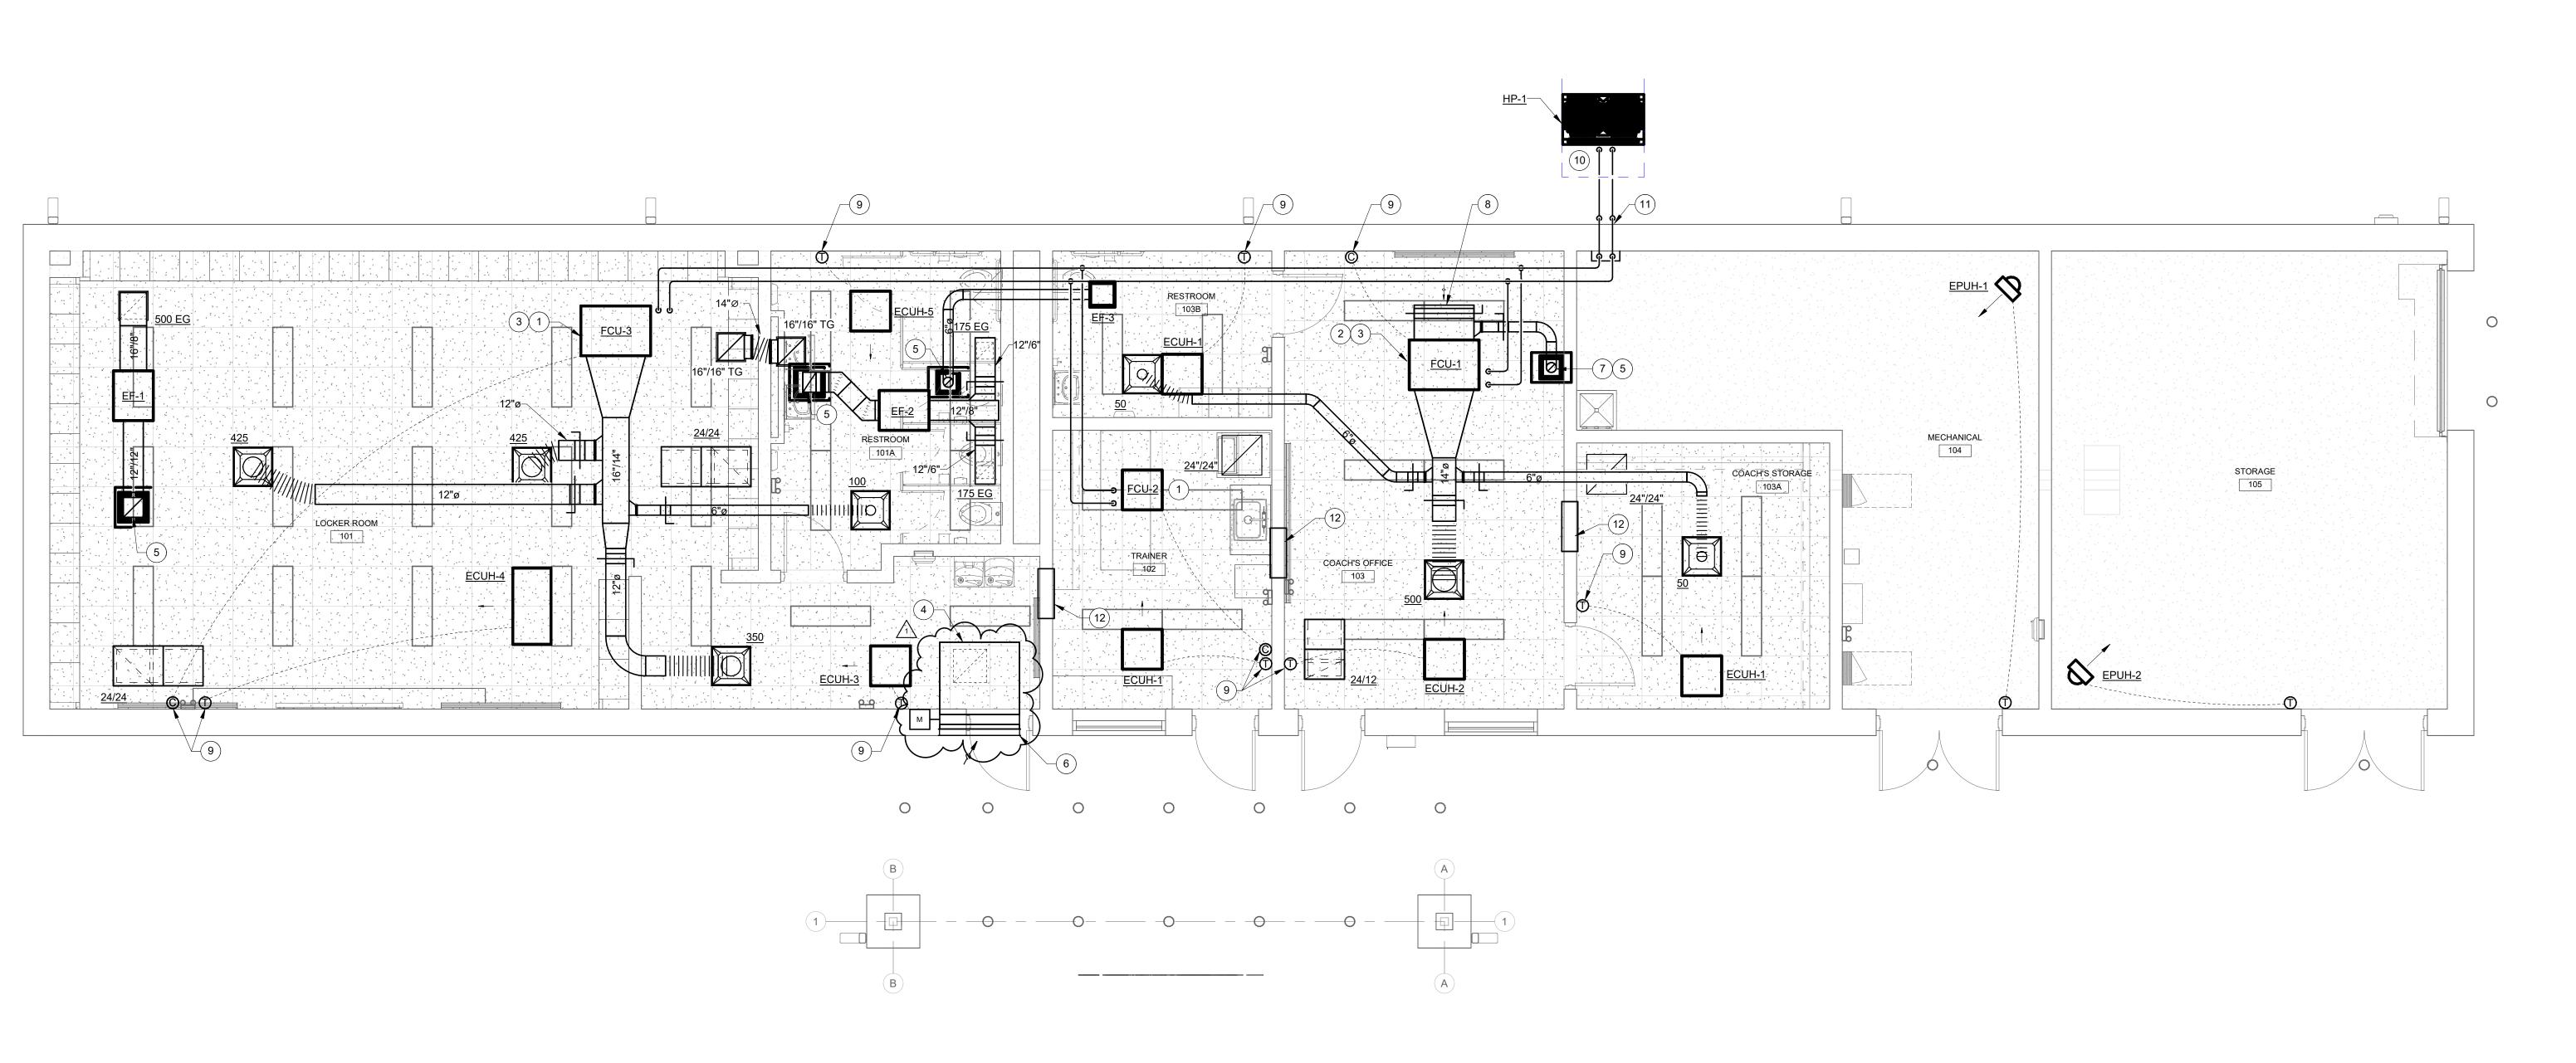



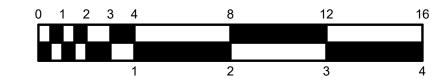



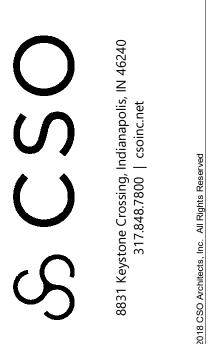



SCOPE DRAWINGS:

These drawings indicate the general scope of the project in terms of architectural design concept, the dimensions of the building, the major architectural elements and the type of structural, mechanical and electrical systems.


The drawings do not necessarily indicate or describe all work required for full performance and completion of the requirements of the Contract.

On the basis of the general scope indicated or described, the trade contractors shall furnish all items required for the proper execution and completion of the work.

**REVISIONS:** ADDENDUM 1 1-17-2025

ISSUE DATE | DRAWN BY | CHECKED BY 12/20/2024

DRAWING TITLE: SOFTBALL LOCKER ROOM -MECHANICAL

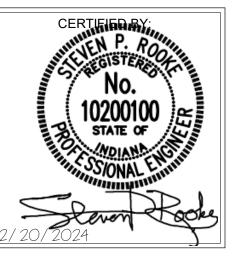

DRAWING NUMBER M201

								F	AN S	CHED	JLE							
MARK	DRAWING		SPECIFICATION		MANUFACTURE				OP	ERATING DA	ATA			N	OTOR DATA	4	WEIGHT	
NO	NAME &/OR PURPOSE	SECTION	NAME	EQUIPMENT TYPE	R & MODEL NO	CFM	TIP SPEED (FPM)	TOT STAT PRESS	RPM	BHP	SONES	DRIVE	WHEEL DIA	HP/KW	VOLTS	PHASE	(LBS)	REMARKS
EF-1	101 LOCKER	23 34 23	HVAC POWER VENTILATORS	IN-LINE FAN	GREENHECK SQ-95-VG	500	4,561	0.5	1,602	0.11	-	DIRECT	-	1/4	120	1	-	DISCONNECT, BACKDRAFT DAMPER, VARIGREEN.
EF-2	101A RESTROOM	23 34 23	HVAC POWER VENTILATORS	IN-LINE FAN	GREENHECK SQ-95-VG	350	4,192	0.5	1,473	0.08	-	DIRECT	-	1/4	120	1	-	DISCONNECT, BACKDRAFT DAMPER, VARIGREEN.
EF-3	103B RESTROOM	23 34 23	HVAC POWER VENTILATORS	CEILING FAN	GREENHECK SP-A125	70	-	0.35	1,100	-	-	DIRECT	-	20 WATTS	120	1	-	DISCONNECT, BACKDRAFT DAMPER, BALANCE DAMPER.
NOTES:					•			-			•							

				VARIA	BLE REFF	RIGERA	NT FLOW	(VRF)	OUTD	OOR UN	IIT SC	HEDUL	E				
MADK	DRAWING NAME		SPECIFICATION	NC	MANUFACTURER	COOLIN	IG CAPACITY	HEAT C	APACITY	CC	MPRESSOF	₹	ELE	ECTRICAL DA	ΑΤΑ	WEIGHT	
MARK NO.		SECTION	NAME	ECHIPMENTIABE			MBIENT FER	MBH	AMBIENT TEMP:	REFRIGERANI	RUTHAUS	IYPE	MCX	VØĽTS	PHASE	WEIGHT (LBS.)	REMARKS
HP-1	M201	23 81 35	MULTI-SPLIT AIR CONDITIONING	OUTDOOR UNIT	TRANE NTXMSM60A182BA	5.0	95.0 11.9	66.0	47.0	R-410A	1	SCROLL	36.0	240	1	-	HEAT PUMP, DISCONNECT.
																^	
																$-$ _1	

				VARIAB	LE REFRIGI	ERAN	IT FLO	W (VR	F) IND	OOR	UNIT S	SCHE	DULE			
MADIC			SPECIFICAT	ION	MANUEA OTUDED 0		CAPACITY		AIRF	LOW		ELECTRIC	CAL DATA		VA/EIOLIT	
MARK NO.	DRAWING NAME &/OR PURPOSE	SECTION	NAME	EQUIPMENT TYPE	MANUFACTURER & - MODEL NO -	COC	LING	HEATING	HI	LOW	MCA	MOCP	VOLTS	PHASE	WEIGHT (LBS.)	REMARKS
110.	a/OITT OITT OOL	SECTION	INAIVIE	EQUIPMENT THE	WODEL NO	THC	SHC	TILATING	ПІ	LOVV	IVICA	IVIOCE	VOL.33	FHASE	(LDO.)	
FCU-1	103 COACH OFFICE	23 81 35	MULTI-SPLIT AIR CONDITIONING	DUCTED HORIZONTAL	TRANE TPEFYP018	18.0	-	20.0	883	618	2.88	15	230	1	67	DISCONNECT, REMOTE THERMOSTAT/CONTROLLER. MEDIUM STATIC. FILTER BOX.
FCU-2	102 TRAINER	23 81 35	MULTI-SPLIT AIR CONDITIONING	CEILING CASSETTE	TRANE TPKFYP006	6.0	-	6.7	191	141	0.24	15	230	1	25	DISCONNECT, REMOTE THERMOSTAT/CONTROLLER.
FCU-3	101 LOCKER	23 81 35	MULTI-SPLIT AIR CONDITIONING	DUCTED HORIZONTAL	TRANE TPEFYP036	36.0	-	40.0	1,271	883	4.25	15	230	1	84	DISCONNECT, REMOTE THERMOSTAT/CONTROLLER. MEDIUM STATIC. FILTER BOX.
	-	•					-				-	-	$\overline{}$		-	

					ELE	CTRIC	UNIT	HEAT	ER SC	HEDU	LE				
MARK			SPECIFICATION		MANUFACTURER	EL	ECTRIC DA	TA				INSTALLED		WEIGHT	
NO	PURPOSE	SECTION	NAME	EQUIPMENT TYPE	& MODEL NO	WATTS	VOLTS	PHASE	DEPTH	WIDTH	HEIGHT	HEIGHT	STYLE	(LBS)	REMARKS
ECUH-1	103A COACH STORAGE/103B RESTROOM/102 TRAINER	23 82 40	UNIT HEATERS - ELECTRIC	CEILING MOUNTED UNIT HEATER	MARKEL HF-3384D-RP	1,500	240	1	-	-	-	-	FULLY RECESSED	-	2 x 2 T-BAR MOUNTING KIT, INTEGRAL THERMOSTAT, DISCONNECT.
ECUH-2	103 COACH OFFICE	23 82 40	UNIT HEATERS - ELECTRIC	CEILING MOUNTED UNIT HEATER	MARKEL HF-3386D-RP	3,000	240	1	-	-	-	-	FULLY RECESSED	-	2 x 2 T-BAR MOUNTING KIT, INTEGRAL THERMOSTAT, DISCONNECT.
ECUH-3	101 LOCKER	23 82 40	UNIT HEATERS - ELECTRIC	CEILING MOUNTED UNIT HEATER	MARKEL HF-3386D-RP	4,000	240	1	-	-	-	-	FULLY RECESSED	-	2 x 2 T-BAR MOUNTING KIT, INTEGRAL THERMOSTAT, DISCONNECT.
ECUH-4	101 LOCKER	23 82 40	UNIT HEATERS - ELECTRIC	CEILING MOUNTED UNIT HEATER	MARKEL 6300 SERIES	12,000	240	1	46"	53"	9-1/2"	-	FULLY RECESSED	-	LINE VOLTAGE THERMOSTAT, TRIM KIT, DISCONNECT.
ECUH-5	101A RESTROOM	23 82 40	UNIT HEATERS - ELECTRIC	CEILING MOUNTED UNIT HEATER	MARKEL HF-3384D-RP	2,000	240		-	-	-	-	FULLY RECESSED	-	2 x 2 T-BAR MOUNTING KIT, INTEGRAL THERMOSTAT, DISCONNECT.
EPUH-1	104 MECHANICAL	23 82 40	UNIT HEATERS - ELECTRIC	PROPELLER UNIT HEATER	TRANE UHEC-03	3,300	240	1	-	-	-	-	HORIZONTAL THROW	-	WALL BRACKET, LINE VOLTAGE THERMOSTAT, DISCONNECT.
EPUH-2	105 STORAGE	23 82 40	UNIT HEATERS - ELECTRIC	PROPELLER UNIT HEATER	TRANE UHEC-07	7,500	240	1	-	-	-	-	HORIZONTAL THROW	-	WALL BRACKET, LINE VOLTAGE THERMOSTAT, DISCONNECT.

	DRAWING		SPECIFICATION		MANII IEACTI IDED		ΔΡ ΑΤ	THR	OAT	HOOD	ROOF	
MARK NO	NAME &/OR PURPOSE	SECTION	NAME	EQUIPMENT TYPE	MANUFACTURER & MODEL NO	MAX CFM	MAX CFM	LENGTH	WIDTH	SIZE	CURB HEIGHT	REMARKS
RIV-A	103 COACH OFFICE	23 37 23	HVAC GRAVITY VENTILATORS	INTAKE	GREENHECK FGI	211	0.030	8"	8"	22" x 27"	12" SLOPED	BIRDSCREEN, CUSTOM COLOR BY ARCHITECT.
RRV-A1 & A2	101 LOCKER/101A RESTROOM	23 37 23	HVAC GRAVITY VENTILATORS	RELIEF	GREENHECK FGR	559	0.043	12"	12"	26" x 27"	12" SLOPED	BIRDSCREEN, CUSTOM COLOR BY ARCHITECT.
RRV-B1	103B RESTROOM	23 37 23	HVAC GRAVITY VENTILATORS	RELIEF	GREENHECK FGR	186	0.024	8"	8"	22" x 27"	12" SLOPED	BIRDSCREEN, CUSTOM COLOR BY ARCHITECT.

E	KHAUS <sup>-</sup>	T/RET	JRN R	EGISTE	R SCHEDULE
MARK NO.	NOMINAL GRILLE SIZE	MAX N.C.	ΜΑΧ ΔΡ	CFM RANGE	REMARKS
0 - 170	8/8	20	0.1"	0 - 170	
175 - 240	10/10	20	0.1"	175 - 240	-
245 - 400	12/12	20	0.1"	245 - 400	-
405 - 520	14/14	20	0.1"	405 - 520	
525 - 640	16/16	20	0.1"	525 - 640	-
645 - 830	18/18	20	0.1"	645 - 830	
835 - 1050	20/20	20	0.1"	835 - 1050	-
1055 - 1400	24/24	20	0.1"	1055 - 1400	-
		CEM	)		

835 - 1050 20/20	20	0.1"	835 - 1050	-
1055 - 1400 24/24	20	0.1"	1055 - 1400	-
1400 EG	DO DET	AUST GRILLE URN GRILLE	MARK NO	

SF SUPPLY FAN EF EXHAUST FAN RF RETURN FAN

	GRILLE	CFM	DUCTED ELBOW		
MARK NO.	SIZE	RANGE	SIZE	'X' DIMEN.	REMARKS
24/6	22/6	0 - 240	22/6	12"	
24/12	22/12	241 - 500	22/8	18"	
24/24	22/22	501 - 900	22/12	24"	
48/24	46/22	901 - 1500	46/12	36"	
/22	(v	EGGCRATE RET PLAN OR SCHE <u>NOTES:</u>	DUCT LINER —	ÆS	LISTED DUCT SIZE  'X'  EXTEND AS REQUIRED WHERE PENETRATING WALL

MARK NO.	SPECIFICATION NAME	MANUFACTURER AND MODEL NO.	CFM RANGE	MAX. N.C.	NECK DIA.	FACE SIZE	CEILING MODULE SIZE
50 - 120	SQUARE CEILING DIFFUSER	PRICE SCDA OR EQUAL	50 - 120	15	6"	24/24	24/24
125 - 245	SQUARE CEILING DIFFUSER	PRICE SCDA OR EQUAL	125 - 245	19	8"	24/24	24/24
250 - 325	SQUARE CEILING DIFFUSER	PRICE SCDA OR EQUAL	250 - 325	19	10"	24/24	24/24
330 - 475	SQUARE CEILING DIFFUSER	PRICE SCDA OR EQUAL	330 - 475	19	12"	24/24	24/24
480 - 645	SQUARE CEILING DIFFUSER	PRICE SCDA OR EQUAL	480 - 645	18	14"	24/24	24/24
650 - 735	SQUARE CEILING DIFFUSER	PRICE SCDA OR EQUAL	650 - 735	18	15"	24/24	24/24
130 - 190	LINEAR SLOT DIFFUSER	PRICE SDS SERIES OR EQUAL	130 - 190	18	8" OVAL	(2) 3/4" SLOTS 48" LONG	N/A
191 - 230	LINEAR SLOT DIFFUSER	PRICE SDS SERIES OR EQUAL	191 - 230	19	8" OVAL	(2) 1" SLOTS 48" LONG	N/A
231 - 270	LINEAR SLOT DIFFUSER	PRICE SDS SERIES OR EQUAL	231 - 270	18	10" OVAL	(3) 3/4" SLOTS 48" LONG	N/A
371 - 340	LINEAR SLOT DIFFUSER	PRICE SDS SERIES OR EQUAL	271 - 340	20	10" OVAL	(3) 1" SLOTS 48 LONG	N/A
341 - 400	LINEAR SLOT DIFFUSER	PRICE SDS SERIES OR EQUAL	341 - 400	21	12" OVAL	(4) 3/4" SLOTS 48" LONG	N/A
401 - 520	LINEAR SLOT DIFFUSER	PRICE SDS SERIES OR EQUAL	401 - 520	22	12" OVAL	(4) 1" SLOTS 48" LONG	N/A

LINEAR SLOT DIFFUSER —



8831 Keystone Crossing, Indianapolis, IN 46240 317.848.7800 | csoinc.net

G. D&A #24097

and Associates, Inc.

NOBLESVILLE HIGH SCHOOL SOFTBALL LOCKER ROOM BUILDING
18111 Cumberland Rd, Noblesville, IN 46060

SCOPE DRAWINGS:

These drawings indicate the general scope of the project in terms of architectural design concept, the dimensions of the building, the major architectural elements and the type of structural, mechanical and electrical systems.


The drawings do not necessarily indicate or describe all work required for full performance and completion of the requirements of the Contract.

On the basis of the general scope indicated or described, the trade contractors shall furnish all items required for the proper execution and completion of the work.

REVISIONS: 1 ADDENDUM 1 1-17-2025

ISSUE DATE | DRAWN BY | CHECKED BY | 12/20/2024 | EJV | SPR

SCHEDULES -MECHANICAL

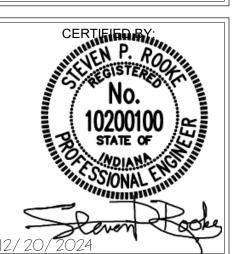


DRAWING NUMBER

M601

PROJECT NUMBER

2024079

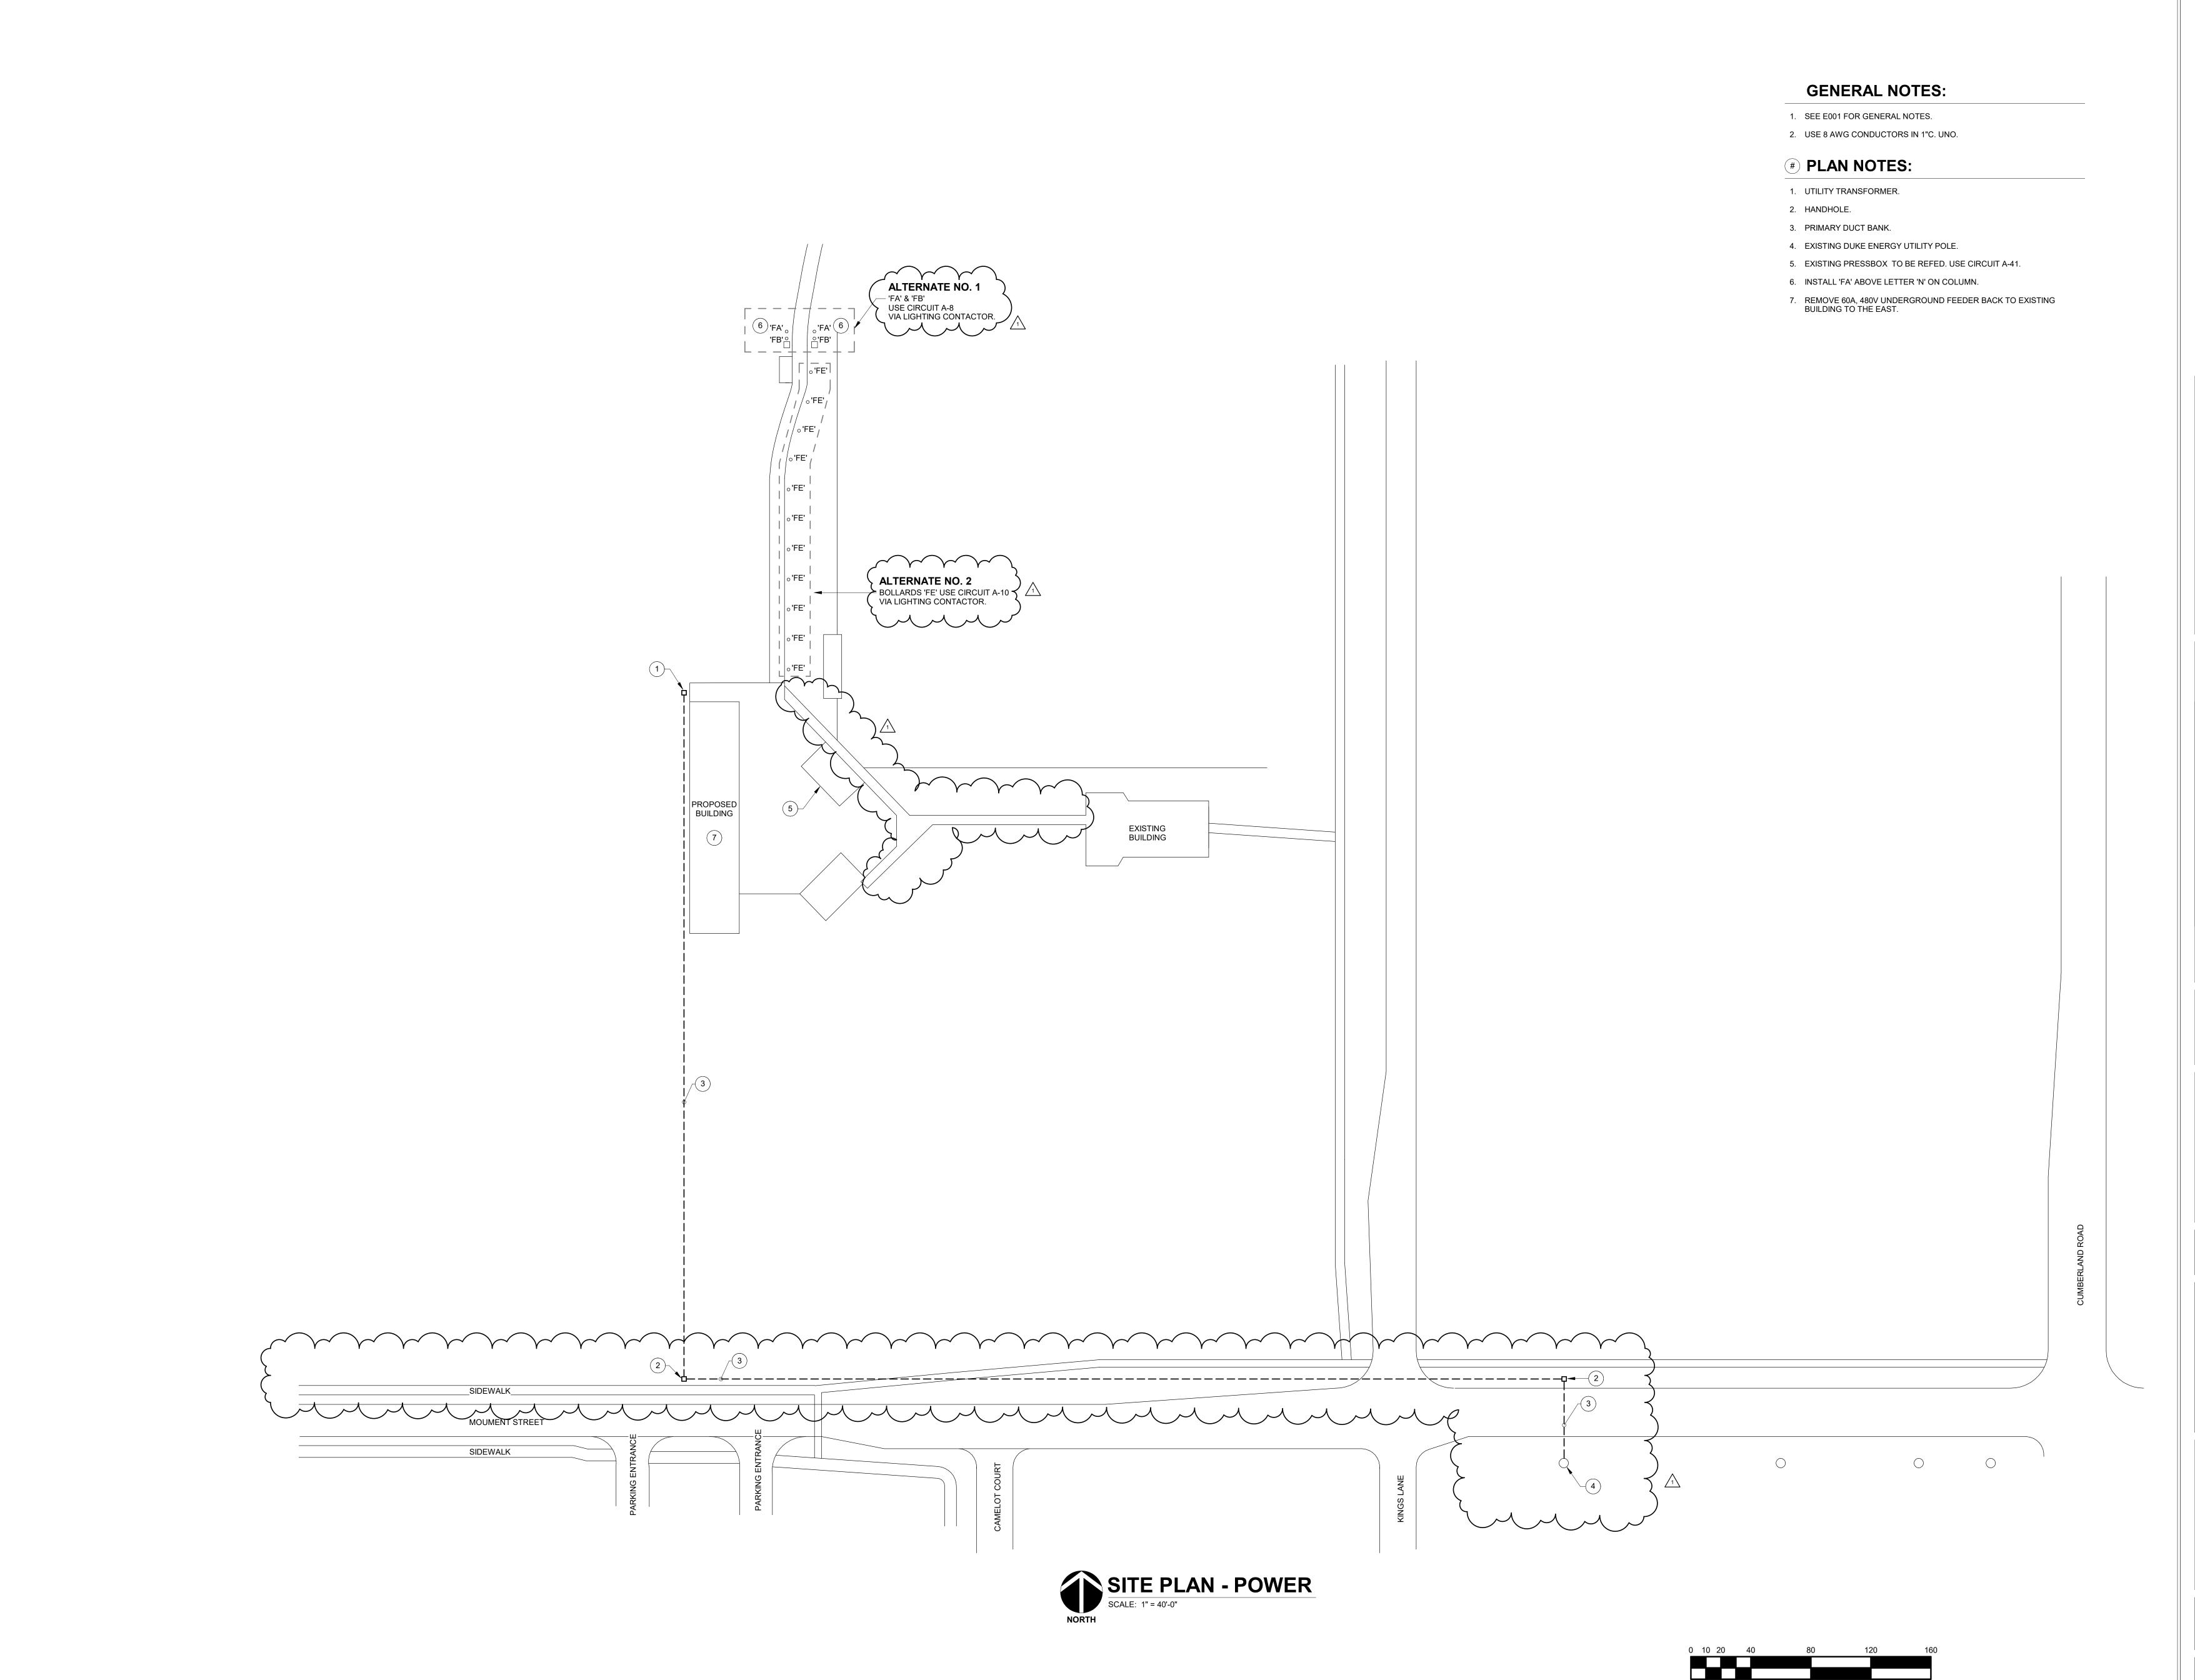

NOBLESVILLE SCHOOLS ENGAGE | INSPIRE | EMPOWER

Keystone Crossing, Indianapolis, IN 46240 317.848.7800 | csoinc.net

D&A #240

and Associates, Inc.
Consulting Engineers

NOBLESVILLE HIGH SCHOOL SOFTBALL LOCKER ROOM BUILDING
18111 Cumberland Rd, Noblesville, IN 46060

SCOPE DRAWINGS:

These drawings indicate the general scope of the project in terms of architectural design concept, the dimensions of the building, the major architectural elements and the type of structural, mechanical and electrical systems.

The drawings do not necessarily indicate or describe all work required for full performance and completion of the requirements of the Contract.

On the basis of the general scope indicated or described, the trade contractors shall furnish all items required for the proper execution and completion of the work.

REVISIONS:
ADDENDUM 1 1-17-2025

ISSUE DATE | DRAWN BY | CHECKED BY


12/20/2024 LPC TH

DRAWING TITLE:

SITE PLAN -ELECTRICAL



E100

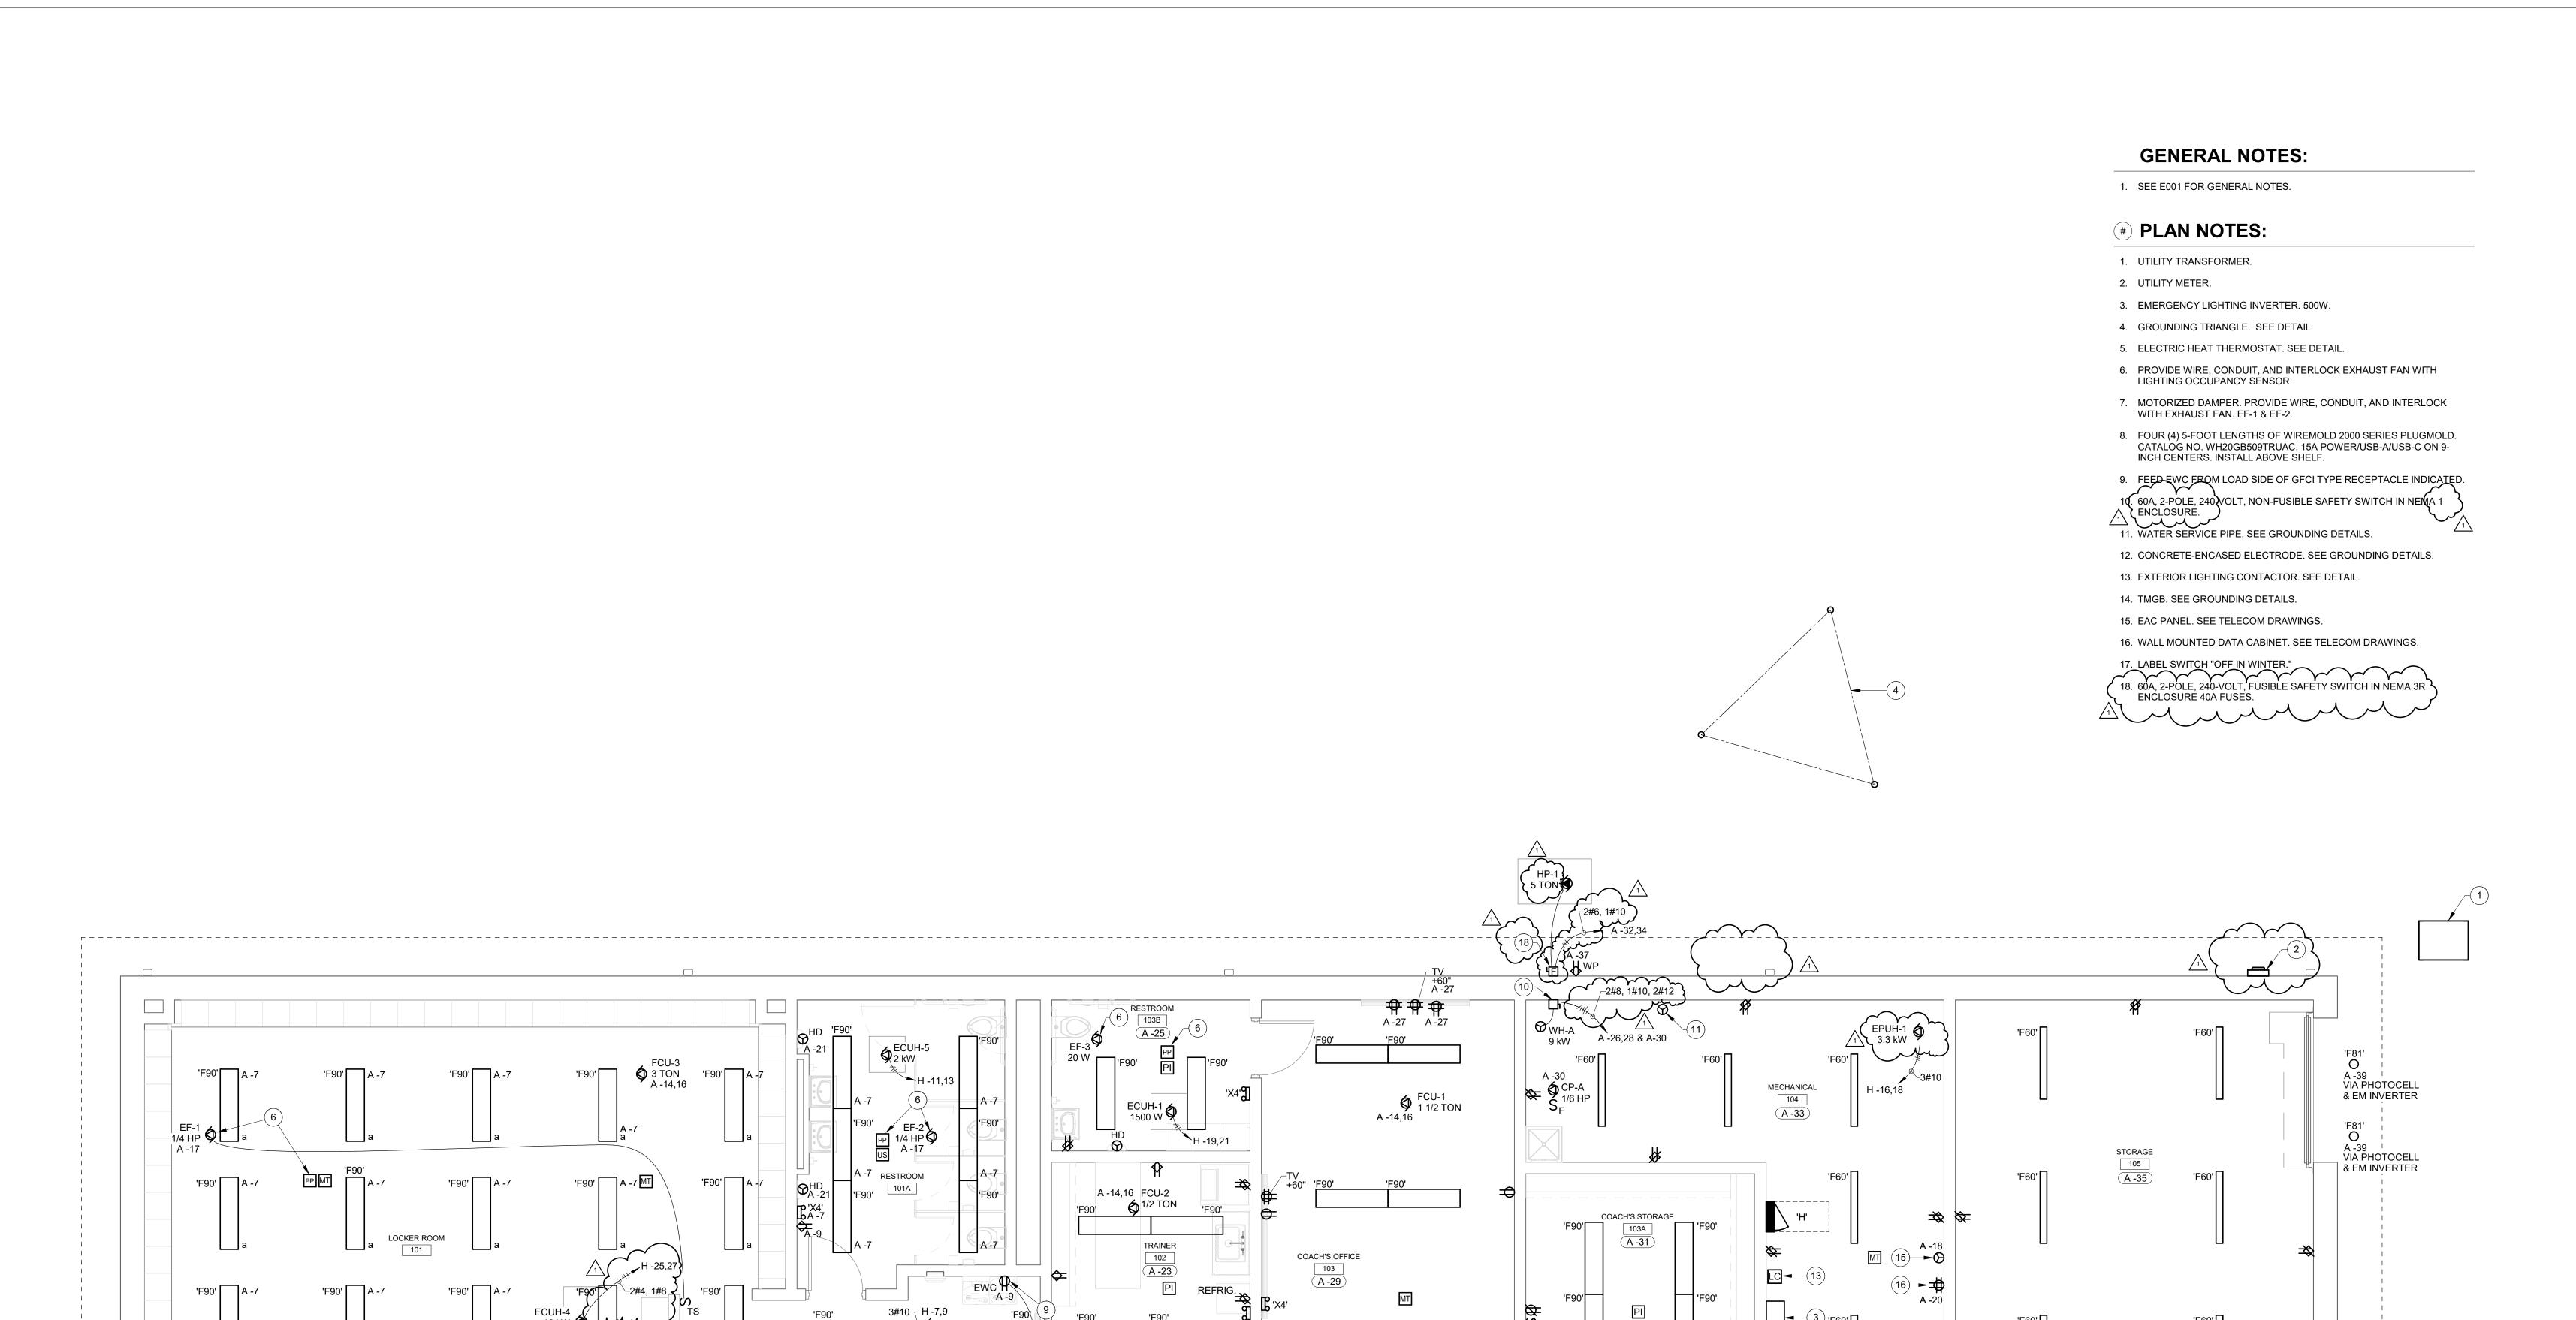




ECUH-1 1 1/2 kW H -15,17

VIA PHOTOCELL & EM INVERTER


ECUH-1

VIA PHOTOCELL & EM INVERTER

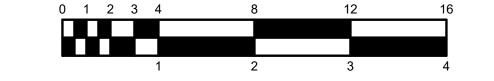

VIA PHOTOCELL & EM INVERTER



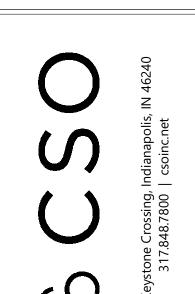





NOBLESVILLE HIGH SCHOOL SOFT LOCKER ROOM BUILDING

SCOPE DRAWINGS:

These drawings indicate the general scope of the project in terms of architectural design concept, the dimensions of the building, the major architectural elements and the type of structural, mechanical and electrical systems.

The drawings do not necessarily indicate or describe all work required for full performance and completion of the requirements of the Contract.

On the basis of the general scope indicated or described, the trade contractors shall furnish all items required for the proper execution and completion of the work.


REVISIONS:
ADDENDUM 1 1-17-2025

ISSUE DATE | DRAWN BY | CHECKED BY 12/20/2024 | LPC | TH

SOFTBALL
LOCKER ROOM ELECTRICAL



E201

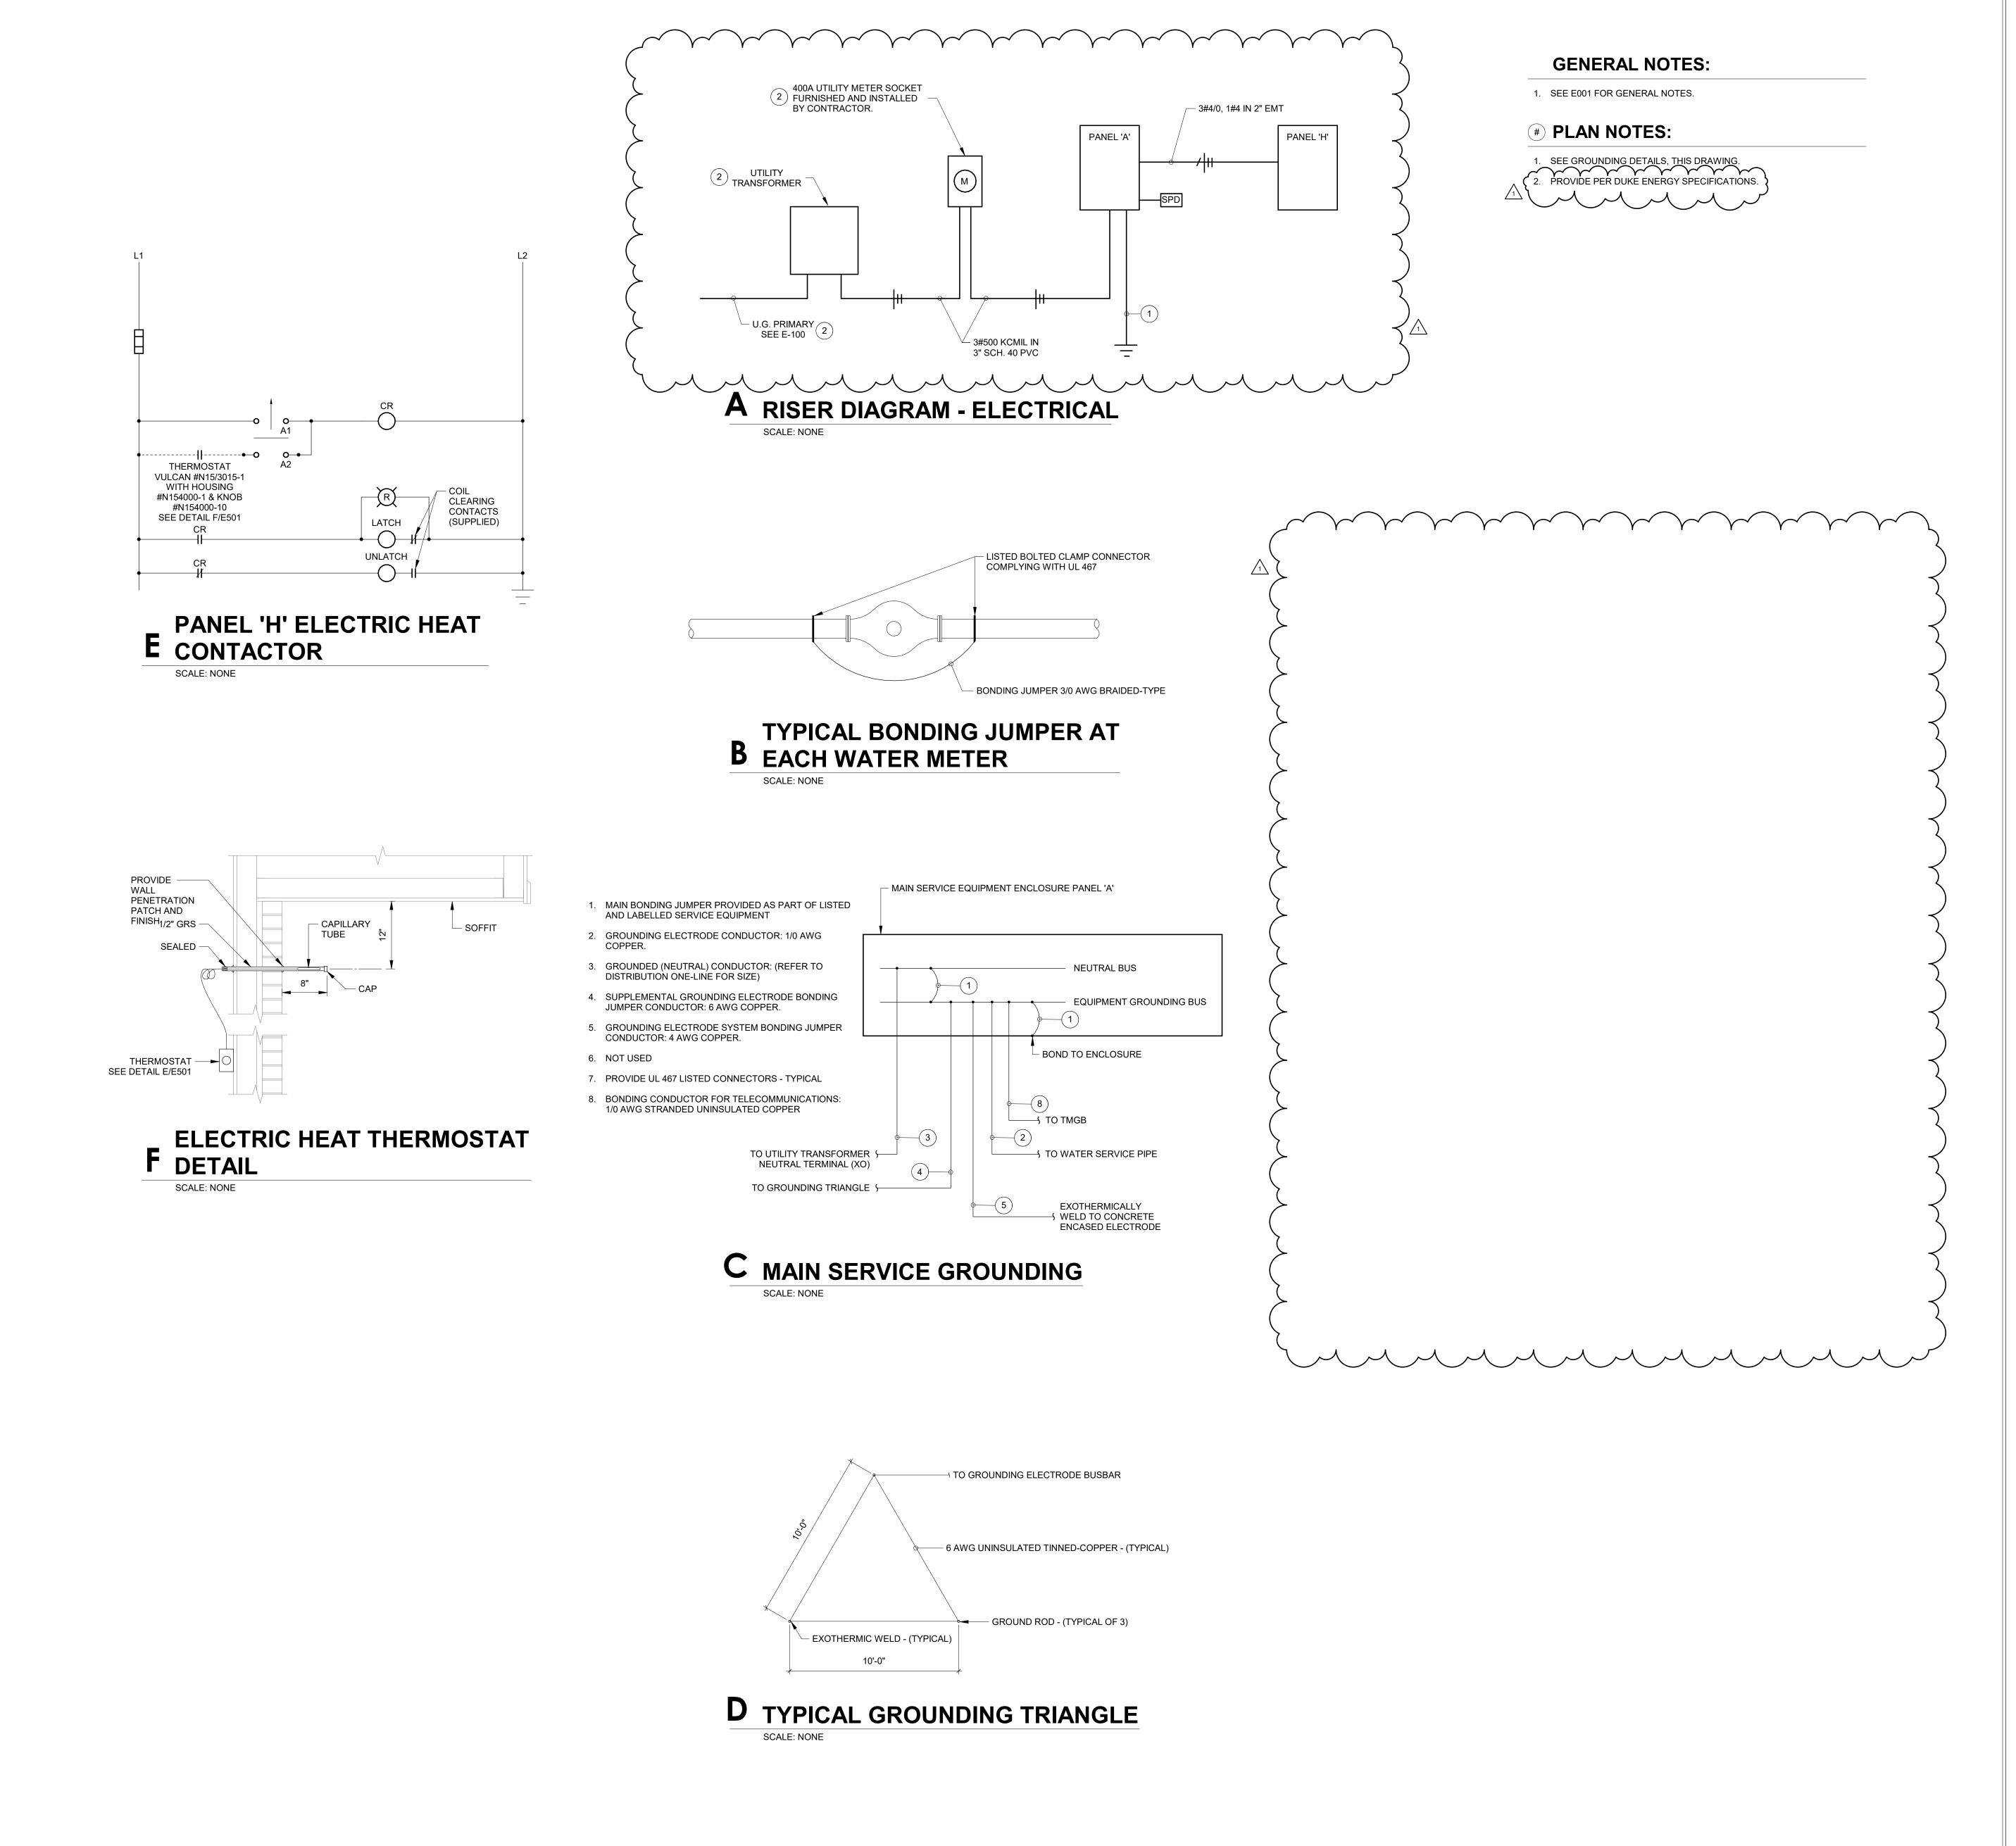

NOBLESVILLE SCHOOLS ENGAGE | INSPIRE | EMPOWER

8831 Keystone Crossing, Indianapolis, IN 46240 317.848.7800 | csoinc.net

hd b&A #24097 s, Inc.

and Associates, Inc.
Consulting Engineers
732 North Capitol Avenue Indianapolis. IN 46204

OBLESVILLE HIGH SCHOOL SOFTBALL LOCKER ROOM BUILDING
18111 Cumberland Rd, Noblesville, IN 46060

SCOPE DRAWINGS:

These drawings indicate the general scope of the project in terms of architectural design concept, the dimensions of the building, the major architectural elements and the type of structural, mechanical and electrical systems.


The drawings do not necessarily indicate or describe all work required for full performance and completion of the requirements of the Contract.

On the basis of the general scope indicated or described, the trade contractors shall furnish all items required for the proper execution and completion of the work.

REVISIONS: 1 ADDENDUM 1 1-17-2025

ISSUE DATE DRAWN BY CHECKED BY
12/20/2024 LPC TH

RISER DIAGRAM
- ELECTRICAL

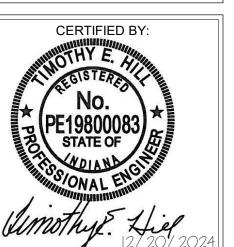

E501

	LI	GHT F	IXTU	RE	SC	HEDU	JLE		
MARK	DESCRIPTION	MOUNTING	WATTS	CRI	COLOR	LUMENS	VOLTS	MANUFACTURER(S)	MAF
F60	4-FOOT LENSED INDUSTRIAL, FORMED STEEL HOUSING, WHITE FINISH, SEMI-FROST ACRYLIC DIFFUSER.	SUSPENDED	48 W	80	3500K	5000	120-277V	COLUMBIA MPS SERIES LITHONIA ZL1D SERIES METALUX SNLED SERIES	F60
F81	2-INCH APERATURE TAMPER RESISTANT DOWNLIGHT, 80CRI, WET LOCATION LISTED, FULL CUT-OFF, FINISH TO BE SELECTED BY ARCHITECT FROM MANUFACTURER'S CATALOG OF STANDARD FINISHES.	RECESSED	20 W	80	3500K	2000	120-277V	GOTHAM EVO2VR SERIES	F8 <sup>2</sup>
F90	1 BY 4-FOOT FLAT PANEL, ACRYLIC LENS, EDGE-LIT, 0-10V DIMMING TO 10-PERCENT	RECESSED	40 W	80	3500K	4000	120-277V	COLUMBIA SRP14 SERIES LITHONIA EPANL14 SERIES METALUX 14FPX SERIES	F90
FA	ACCENT LIGHT, 45 DEGREE CUTOFF	WALL ARM	5 W	80	4000K	300	120-277V	HYDREL CEDAR LED	FA
FB	UPLIGHT	INGRADE	22 W	80	4000K	2000	120-277V	HYDREL TIERRA IGF6	FB
FE	36.2-INCH TALL, 4.5-INCH SQUARE STAINLESS STEEL BOLLARD, INTEGRAL DRIVER, WET LOCATION LISTED, IP66 RATED, FINISH TO BE SELECTED BY ARCHITECT FROM MANUFACTURER'S CATALOG OF STANDARD FINISHES.	CONCRETE BASE	14 W	70	4000K	780	120-277V	FORMS + SURFACES RINCON BOLLARD SERIES	FE
X4	EMERGENCY LIGHTING UNIT, 90-MINUTE EMERGENCY CAPACITY, DAMP LOCATION LISTED, SELF DIAGNOSTIC.	SURFACE WALL	5 W	80	WHITE	N/A	120-277V	DUAL-LITE EV SERIES SURE-LITES SEL25 SERIES LITHONIA ELM2 SERIES	X4

CATION:	MECHANICAL 104	SCCR (AN	IPS RMS	SYMM):	10000	SEI	RVICE: 1		1Ф 3-Wire+Gr	ound ) MAIN: MCB	;
OUNTIN	SURFACE			-		WE NE	MA.—1			AMP: 400 A	A
СКТ	DESCRIPTION	NOTE	AMP	POLE	Α	В	POLE	AMP	NOTE	DESCRIPTION	СКТ
1	SPARE		20 A	1	0/0		1	20 A		SPARE	2
3	SPARE		20 A	1		0/0	1	20 A		SPARE	4
5	SPARE		20 A	1	0/0		1	20 A		SPARE	6
7	LTG - 101, 101A		20 A	1		935 / 0	1	20 A		ENTRY ARCH	8
9	EWC - 101		20 A	1	1044 / 364		1	20 A		BOLLARDS	10
11	RECEPTS - 101, 101A		20 A	1		540 / 0	1	20 A		SPARE	12
13	PLUGMOLD - 101		20 A	1	1440 / 766		2	15 A		FAN COILS	14
15	PLUGMOLD - 101		20 A	1		1440 / 766		1071		1711 00120	16
17	EF - 101 & 101A		15 A	1	1392 / 1000		1	20 A		EAC PANEL	18
19	SPARE		20 A	1		0 / 1000	1	20 A		DATA CABINET	20
21	HAND DRYERS - 101A		20 A	1	400 / 0		2	15 A		SPARE	22
23	TRAINER 102		20 A	1		1065 / 0		~~~			~~24~
25	RESTROOM 103B		20 A	1	1285 / 4500		2 (	γ 50 A	Ψ	WH-A	26
27	COACHES OFFICE 103		20 A	1		1080 / 4500	\ \ \	ا 00 A ماسد	۔ ا مہ ا	\	28
29	COACHES OFFICE 103		20 A	1	1145 / 520		_ 1 _	15 A		CP-A & WH CONTROL CIRCUIT	
31	COACHES STORAGE 103A		20 A	1		340 / 4320	2	60 A		A A A A A A A A A A A A A A A A A A A	32
33	MECHANICAL 104		20 A	1	1145 / 4320		2	60 A		5 TON CU	34
35	STORAGE 105		20 A	1		1008 / 0	2	20 A		SPARE	36
37	OUTDOOR RECEPTS		20 A	1	180 / 0			20 A		SPARE	38
39	SOFFIT LTS		20 A	1		320 / 0	2	20.4		SPD	40
41	PRESSBOX		20 A	1 🕻	1000 / 0		2	30 A		24D	42
					$\overline{}$	$\sim$	$\sim$		$\overline{}$		
			TC	OTALS :	38651 VA	35464 VA				$\overline{}$	
TOTA	AL CONNECTED LOAD (VA): 74115 VA			•		TOTAL CONNE	CTED LO	AD (AMP	<b>S)</b> : 309 A		
EMARKS:						NOTES:					-

	Н		A PANELBOARD SCHEDULE									
LOCATIO	N: MECHANICAL 104	SCCR (AN	MPS RMS	SYMM):	10000	SE	RVICE: 1	20/240V	т 1Ф 3-Wire+	-Ground ) MAIN: MCB		
MOUNTIN	SURFACE					WE NE	MA. ~1		TO 3-VVIII ET	<b>AMP</b> : 225 A		
CICT	DESCRIPTION	NOTE	AMD	DOL E	•		I BOLE	AMD	NOTE	DESCRIPTION	OVE	
СКТ	DESCRIPTION  SPARE	NOTE	AMP	POLE 1	A	В	POLE	AMP	NOTE	DESCRIPTION  SPARE	СКТ	
1	SPARE		20 A	1	0/0	0.40	1	15 A		SPARE	2	
3	SPARE		30 A	2	0.70	0/0	2	30 A		SPARE	4	
5					0/0	0000 / 4500					6	
7	ECUH-3 LOCKER RM 101		30 A	2	0000 / 4500	2000 / 1500	2	20 A		ECUH-2 COACHES OFFICE 103	8	
9					2000 / 1500	1000 / 750					10	
11	ECUH-5 RESTROOM 101A		15 A	2	1000 / 750	1000 / 750	2	15 A		ECUH-1 COACHES STORAGE 103A	12	
13					1000 / 750	750 / 1050					14	
15	ECUH-1 TRAINER 102		15 A	2		750 / 1650	2	20 A		EPUH-1 MECHANICAL 104	16	
17					750 / 1650						18	
19	ECUH-1 RESTROOM 103B		15 A	2		750 / 3750	2	50 A		EPUH-2 STORAGE 105	20	
21					750 / 3750						22	
$\frac{23}{2}$	SPARE	~~~	15 A	1 1		0/0		20 A	~~~	SPARE	24	
25	ECUH-4 LOCKER RM 101		70 A	2	6000 / 0		2	40 A		SPARE	26	
27						6000 / 0		_			28	
29	SPARE		20 A	1	0/0		1	20 A		SPARE	30	
<u>ىر ب</u>	MMMMM MM		<u>~                                    </u>	بريد	MM		<u>ىر ب</u>			white me had the many that the same and the		
			TC	OTALS :	18150 VA	18150 VA						
	TAL CONNECTED LOAD (VA): 36300 VA					TOTAL CONNE	CTED LO	AD (AMP	<b>'S)</b> : 151 A			
REMARKS						NOTES:						
NLINE ME	ECHANICALLY HELD CONTACTOR. SEE DET	ΓAIL.										



8831 Keystone Crossing, Indianapolis, IN 46240 317.848.7800 | csoinc.net

D&A #240

and Associates, Inc.

NOBLESVILLE HIGH SCHOOL SOFTBALL LOCKER ROOM BUILDING
18111 Cumberland Rd, Noblesville, IN 46060

SCOPE DRAWINGS:

These drawings indicate the general scope of the project in terms of architectural design concept, the dimensions of the building, the major architectural elements and the type of structural, mechanical and electrical systems.


The drawings do not necessarily indicate or describe all work required for full performance and completion of the requirements of the Contract.

On the basis of the general scope indicated or described, the trade contractors shall furnish all items required for the proper execution and completion of the work.

REVISIONS: 1 ADDENDUM 1 1-17-2025

ISSUE DATE DRAWN BY CHECKED BY 12/20/2024 LPC TH

SCHEDULES -ELECTRICAL

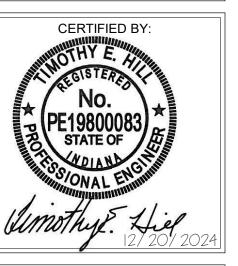

E601